

Harrison
E
2027

MISSISSIPPI DEPARTMENT OF NATURAL RESOURCES
 Bureau of Land and Water Resources
 Southport Mall
 P.O. Box 10631
 Jackson, Mississippi 39209
WATER WELL DRILLERS LOG

Nov. 23 1981
 date well completed

Duncan Well Drilling
 firm name

Harrison
 county well located

LANDOWNER: Jean Bullman
Rt. 1 Box 628-B
Pass Christian
 (mailing address)

description of formations encountered	from	to
<u>Sand & mud</u>	<u>0</u>	<u>21</u>
<u>Red Clay</u>	<u>21</u>	<u>42</u>
<u>fine sand</u>	<u>42</u>	<u>63</u>
<u>coarse sand</u>	<u>63</u>	<u>100</u>

WELL LOCATION:
 sec. 32 T. 6 N. R. 13 E.
7 miles S of Vidalia
 (distance) (direction) (nearest town)

WELL PURPOSE: Home
 (home, irrigation, municipal, industrial)

- WELL COMPLETION DATA:
- (1) diameter (inches) 2"
 - (2) total depth (feet) 100'
 - (3) static water level (feet) 22' below above top of ground.
 - (4) casing PVC, 90'
 (material) (depth)
 - (size) If telescope see back.
 - (5) screen 10', 90'
 (length) (depth to top)
 - 2", PVC
 (size) (material)
 - (6) pump 1, 12
 (HP) (yield gpm)
 - electric
 (type power)
 - (7) electric log (yes or no) _____

(organization running log) _____
 (8) how well bottom plugged hard
shut

DRILLERS REMARKS: _____


MISSISSIPPI DEPARTMENT OF NATURAL RESOURCES
 BUREAU OF LAND & WATER RESOURCES

FEB 11 1982

RECEIVED

If well telescopes please sketch and show depths.

GROUND LEVEL

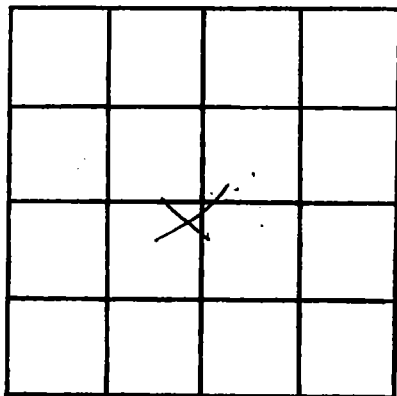

SECTION 7

Please indicate well location X.

ADDITIONAL INFORMATION

If more than one screen,
show locations of each on sketch.