

MISSISSIPPI DEPARTMENT OF NATURAL RESOURCES

Bureau of Land and Water Resources

Southport Mall

P.O. Box 10631

Jackson, Mississippi 39209

WATER WELL DRILLERS LOG

Harrison
E
2029

Feb. 1 1982 Duncan Well Drilling Harrison
date well completed firm name county well located

LANDOWNER:	description of formations encountered	from	to
<u>Frederick Sapio</u>	<u>Sand + Mud</u>	<u>0</u>	<u>21</u>
<u>Rt. 1 Box 621 P</u>	<u>Red Clay</u>	<u>21</u>	<u>42</u>
<u>Law Christian</u>	<u>Fine Sand</u>	<u>42</u>	<u>63</u>
(mailing address)	<u>Coarse Sand</u>	<u>63</u>	<u>84</u>
WELL LOCATION:			
sec <u>32</u> T <u>6</u> N R <u>13</u> E (distance) <u>3</u> miles (direction) <u>SE</u> of <u>Vicksburg</u> (nearest town)			
WELL PURPOSE: <u>Home</u> (home, irrigation, municipal, industrial)			
WELL COMPLETION DATA:			
(1) diameter (inches) <u>2"</u>			
(2) total depth (feet) <u>84 ft.</u>			
(3) static water level (feet) <u>7'</u> <u>below</u> above top of ground.			
(4) casing <u>PVC</u> , <u>74'</u> (material) (depth)			
_____ If telescope see back. (size)			
(5) screen <u>10'</u> , <u>74'</u> (length) (depth to top)			
_____ <u>2"</u> , <u>PVC</u> (size) (material)			
(6) pump <u>1</u> , <u>12</u> (HP) (yield gpm)			
<u>electric</u> (type power)			
(7) electric log _____ (yes or no)			
_____ (organization running log)			
(8) how well bottom plugged <u>sand</u> <u>shark</u>			
DRILLERS REMARKS:			


DEPT. OF NATURAL RESOURCES
BUREAU OF LAND & WATER RESOURCES

FEB 11 1982

RECEIVED

If well telescopes please sketch and show depths.

GROUND LEVEL

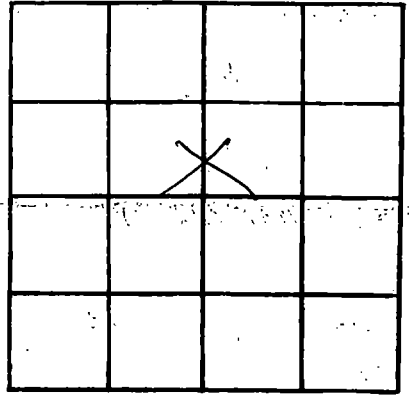

SECTION 32

Please indicate well location X.

ADDITIONAL INFORMATION

Lined area for additional information.

If more than one screen, show locations of each on sketch.