

MISSISSIPPI DEPARTMENT OF NATURAL RESOURCES

Bureau of Land and Water Resources

Southport Mall

P.O. Box 10631

Jackson, Mississippi 39209

WATER WELL DRILLERS LOG

Harrison
E
2030

11/25/81 19 Lyman Well Co. Harrison
 date well completed firm name county well located

LANDOWNER: Ulan Moran
Moran Rd
Lyana, MS
 (mailing address)

description of formations encountered	from	to
Red sand	0	70
gray		
Red Clay & white	70	105
Clay & Blue Clay		
Mixed Sand & Clay	105	185
Sand	185	207

WELL LOCATION:
 sec. 14 T. 6 N. R. 13 E. S. 5 W. of Greene
 (distance) miles (direction) of (nearest town)

WELL PURPOSE: home
 (home, irrigation, municipal, industrial)

WELL COMPLETION DATA:

(1) diameter (inches) 2"

(2) total depth (feet) 207'

(3) static water level (feet) 40' below above top of ground.

(4) casing PVC, 197'
 (material) (depth)
2" if telescope see back.
 (size)

(5) screen 10', 197'
 (length) (depth to top)
2" PVC
 (size) (material)

(6) pump 1 12
 (HP) (yield gpm)
electric
 (type power)

(7) electric log No
 (yes or no)
NO
 (organization running log)

(8) how well bottom plugged sand
shark.

DRILLERS REMARKS:


MISSISSIPPI DEPARTMENT OF NATURAL RESOURCES
 BUREAU OF LAND AND WATER RESOURCES

NOV 29 1981

RECEIVED

If well telescopes please sketch and show depths.

GROUND LEVEL

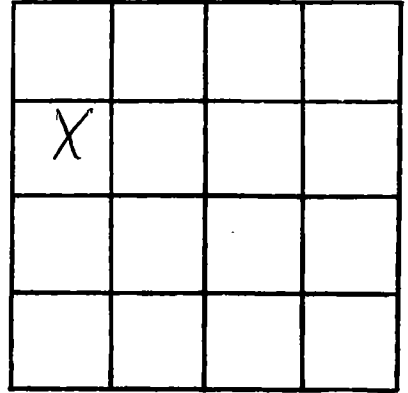

SECTION 14

Please indicate well location X.

ADDITIONAL INFORMATION

If more than one screen, show locations of each on sketch.