

MISSISSIPPI DEPARTMENT OF NATURAL RESOURCES

Bureau of Land and Water Resources

Southport Mall

P.O. Box 10631

Jackson, Mississippi 39209

WATER WELL DRILLERS LOG

Harrison
E
2031

3/2 19 82 date well completed 82 Lyman well Co. firm name Harrison County county well located

LANDOWNER: <u>Johanny Cuevas</u>	description of formations encountered	from	to
<u>Lizana Mo.</u> <u>Moran Rd</u> (mailing address)	<u>Red sand Clay & gravel</u> <u>Clay</u> <u>Sand</u>	0	40
WELL LOCATION: sec. <u>11</u> T. <u>6</u> N. R. <u>13</u> E. <u>2</u> miles <u>S</u> of <u>LIZANA</u> (distance) (direction) (nearest town)		40	70
		70	106
WELL PURPOSE: <u>HOME</u> (home, irrigation, municipal, industrial)			
WELL COMPLETION DATA: (1) diameter (inches) <u>2"</u> (2) total depth (feet) <u>106</u> (3) static water level (feet) <u>25' below</u> top of ground. (4) casing <u>PVC</u> , <u>96</u> , (material) (depth) <u>2"</u> (size) If telescope see back. (5) screen <u>10'</u> , <u>106</u> (length) (depth to top) <u>2"</u> , <u>PVC</u> (size) (material) (6) pump <u>N/A</u> <u>N/A</u> (HP) (yield gpm) <u>N/A</u> (type power) (7) electric log <u>NO</u> (yes or no) <u>N/A</u> (organization running log) <u>Sand Shark</u> (8) how well bottom plugged <u>Sand Shark</u>			
DRILLERS REMARKS:			


DEPT. OF NATURAL RESOURCES
BUREAU OF LAND AND WATER RESOURCES

APR 22 1982

RECORDED

If well telescopes please sketch and show depths.

GROUND LEVEL

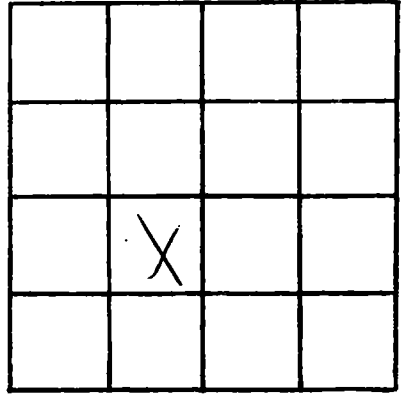

SECTION 11

Please indicate well location X.

ADDITIONAL INFORMATION

If more than one screen, show locations of each on sketch.