

MISSISSIPPI DEPARTMENT OF NATURAL RESOURCES

Bureau of Land and Water Resources

Southport Mall

P.O. Box 10631

Jackson, Mississippi 39209

WATER WELL DRILLERS LOG

Harrison
E
2032

March 26 1982 *Duncan Well Drilling Harrison*
 date well completed firm name county well located

LANDOWNER: *Alton E. Justice*
1045 Edgewater Dr. NW
Atlanta, Ga. 30328
 (mailing address)

description of formations encountered	from	to
<i>Sand & Mud</i>	<i>0</i>	<i>21</i>
<i>fine Sand</i>	<i>21</i>	<i>63</i>
<i>Blue Clay</i>	<i>63</i>	<i>159</i>
<i>Course Sand</i>	<i>159</i>	<i>179</i>

WELL LOCATION:
 sec. *32* T. *6* N. R. *13* E.
2 miles *S* of *Vadalia*
 (distance) (direction) (nearest town)

WELL PURPOSE: *House*
 (home, irrigation, municipal, industrial)

WELL COMPLETION DATA:
 (1) diameter (inches) *2"*
 (2) total depth (feet) *189 ft.*
 (3) static water level (feet) *10'* below above top of ground.
 (4) casing *PVC*, *179'*
 (material) (depth)
 (size) if telescope see back.
 (5) screen *10'*, *179'*
 (length) (depth to top)
2", *PVC*
 (size) (material)
 (6) pump (HP) (yield gpm)
 (type power)
 (7) electric log (yes or no)
 (organization running log)
 (8) how well bottom plugged *Sand*
Mark

DRILLERS REMARKS: *Owner had his own pump*


DEPT. OF NATURAL RESOURCES
 BUREAU OF LAND & WATER RESOURCES

AUG 30 1982

RECEIVED

If well telescopes please sketch and show depths.

GROUND LEVEL

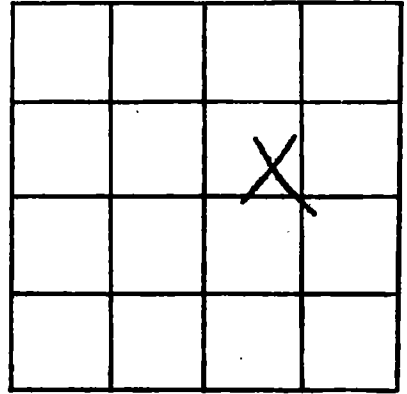

SECTION 32

Please indicate well location X.

ADDITIONAL INFORMATION

If more than one screen, show locations of each on sketch.