

MISSISSIPPI DEPARTMENT OF NATURAL RESOURCES

Bureau of Land and Water Resources

Southport Mall

P.O. Box 10631

Jackson, Mississippi 39209

WATER WELL DRILLERS LOG

Harrison
E
2033

March 29 1982 Duncan Well Drilling Harrison
 date well completed firm name county well located

LANDOWNER: Carl Moon
Rt. 1 Box 621 EE
Pass Christian, Ms.
 (mailing address)

description of formations encountered	from	to
<u>Sand & Mud</u>	<u>0</u>	<u>21</u>
<u>Clay</u>	<u>21</u>	<u>42</u>
<u>fine Sand</u>	<u>42</u>	<u>84</u>
<u>Coarse Sand</u>	<u>84</u>	<u>100</u>

WELL LOCATION:
 sec 32 T 6 N R 13 E
2 miles S of Udelsia
 (distance) (direction) (nearest town)

WELL PURPOSE: Home
 (home, irrigation, municipal, industrial)

WELL COMPLETION DATA:
 (1) diameter (inches) 2"
 (2) total depth (feet) 100 ft.
 (3) static water level (feet) 80 ^(below) _{above} top of ground.
 (4) casing PVC, 90'
 (material) (depth)
 (size) if telescope see back.
 (5) screen 10' 90'
 (length) (depth to top)
2" PVC
 (size) (material)
 (6) pump 1 10
 (HP) (yield gpm)
electric
 (type power)
 (7) electric log
 (yes or no)
 (organization running log)
 (8) how well bottom plugged Sand
Shark

DEPT. OF NATURAL RESOURCES
 BUREAU OF LAND & WATER RESOURCES


AUG 30 1982

RECEIVED

DRILLERS REMARKS:

If well telescopes please sketch and show depths.

GROUND LEVEL

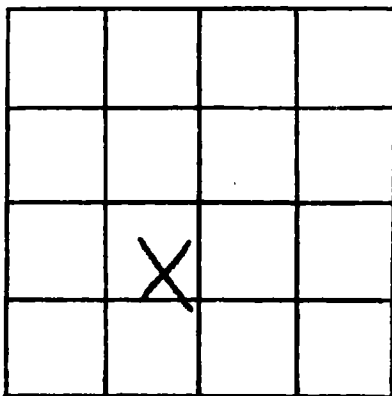

SECTION 32

Please indicate well location X.

ADDITIONAL INFORMATION

If more than one screen,
show locations of each on sketch.