

MISSISSIPPI DEPARTMENT OF NATURAL RESOURCES

Bureau of Land and Water Resources

Southport Mall

P.O. Box 10631

Jackson, Mississippi 39209

WATER WELL DRILLERS LOG

Hanson
E
2035

May 4 1982 Duncan Well Drilling Harrison
date well completed firm name county well located

LANDOWNER: Eldio Ligma
1021 Pinto St.
Long Beach, Ms.
(mailing address)

description of formations encountered	from	to
Mud & Sand	0	40
Sand	40	60
Clay	60	80
Coarse Sand	80	100

WELL LOCATION:
sec. 30 T 6 N R 13 E
8 miles SW of Lumberton
(distance) (direction) (nearest town)

WELL PURPOSE: Home
(home, irrigation, municipal, industrial)

- WELL COMPLETION DATA:
- (1) diameter (inches) 2"
 - (2) total depth (feet) 100'
 - (3) static water level (feet) 20' below above top of ground.
 - (4) casing PVC 90' (material) (depth)
 - (size) If telescope see back.
 - (5) screen 10' 90' (length) (depth to top)
 - 2" PVC (size) (material)
 - (6) pump (HP) (yield gpm)
 - electric (type power)
 - (7) electric log (yes or no)
 - (organization running log)
 - (8) how well bottom plugged Sand
 - sharp

DEPT. OF NATURAL RESOURCES
BUREAU OF LAND & WATER RESOURCES


AUG 27 1982

RECEIVED

DRILLERS REMARKS: Owner has his own pump

If well telescopes please sketch and show depths.

GROUND LEVEL

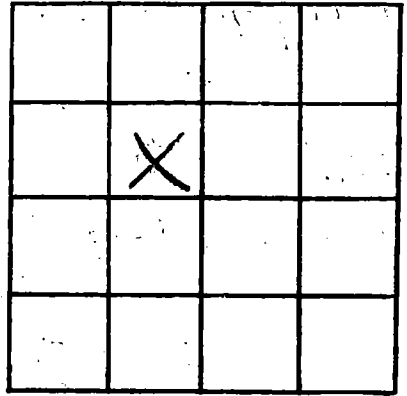

SECTION 30

Please indicate well location X.

ADDITIONAL INFORMATION

If more than one screen, show locations of each on sketch.