

MISSISSIPPI DEPARTMENT OF NATURAL RESOURCES

Bureau of Land and Water Resources

Southport Mall

P.O. Box 10631

Jackson, Mississippi 39209

WATER WELL DRILLERS LOG

Harrison
E
2037

Sept. 7 1982 Duncan Well Drilling Harrison
 date well completed firm name county well located

LANDOWNER: Elder Cuevas
Rt. 2 Box 118 H
Luzina Mo. 39503
 (mailing address)

description of formations encountered	from	to
	<u>clay</u>	<u>0</u>
<u>clay sand mixed</u>	<u>60</u>	<u>100</u>
<u>fine sand</u>	<u>100</u>	<u>160</u>
<u>course sand</u>	<u>160</u>	<u>200</u>

WELL LOCATION:
 sec. 18 T. 6 N. R. 12 E.
1 1/2 miles SW of Luzina
 (distance) (direction) (nearest town)

WELL PURPOSE: home
 (home, irrigation, municipal, industrial)

WELL COMPLETION DATA:

(1) diameter (inches) 2"

(2) total depth (feet) 200 ft.

(3) static water level (feet) 28' below above top of ground.

(4) casing PVC, 190'
 (material) (depth)

_____ If telescope see back.
 (size)

(5) screen 10', 190'
 (length) (depth to top)

2", PVC
 (size) (material)

(6) pump _____ (HP) _____ (yield gpm)

_____ (type power)

(7) electric log _____ (yes or no)

_____ (organization running log)

(8) how well bottom plugged Sand

DRILLERS REMARKS: Owner installed own pump


DEPT. OF NATURAL RESOURCES
 BUREAU OF LAND & WATER RESOURCES

JAN 21 1983

RECEIVED

If well telescopes please sketch and show depths.

GROUND LEVEL

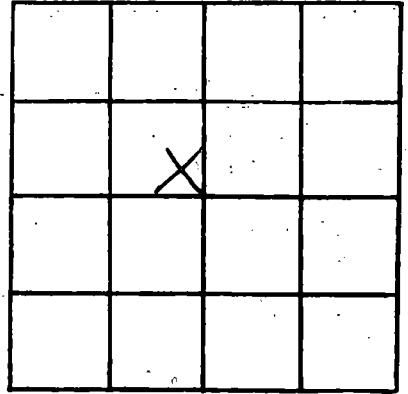

SECTION 18

Please indicate well location X.

ADDITIONAL INFORMATION

If more than one screen, show locations of each on sketch.