

MISSISSIPPI DEPARTMENT OF NATURAL RESOURCES

Bureau of Land and Water Resources

Southport Mall

P.O. Box 10631

Jackson, Mississippi 39209

WATER WELL DRILLERS LOG

<i>Harrison</i>
<i>E</i>
<i>2038</i>

Sept. 8 19*82*
date well completed

Duncan Well Drilling
firm name

Harrison
county well located

LANDOWNER:	Description of formations encountered	from	to
<i>Franklin Houston</i>	<i>Clay</i>	<i>0</i>	<i>20</i>
<i>P.O. Box 317</i>	<i>fine sand</i>	<i>20</i>	<i>25</i>
<i>Hurley, Mo.</i>	<i>Blue Clay</i>	<i>25</i>	<i>203</i>
<i>1</i> (mailing address)	<i>fine sand</i>	<i>203</i>	<i>230</i>
WELL LOCATION:	<i>Course Sand</i>	<i>230</i>	<i>325</i>
sec. <i>32</i> T <i>6</i> N R <i>13</i> E			
<i>6.6</i> miles <i>S.W.</i> of <i>Lynn</i>			
(distance) (direction) (nearest town)			
WELL PURPOSE: <i>home</i>			
(home, irrigation, municipal, industrial)			
WELL COMPLETION DATA:			
(1) diameter (inches) <i>2"</i>			
(2) total depth (feet) <i>375 ft.</i>			
(3) static water level (feet) <i>25'</i> below above top of ground.			
(4) casing <i>PVC</i> <i>365</i>			
(material) (depth)			
<i>10'</i> If telescope see back.			
(size)			
(5) screen <i>10'</i> <i>365</i>			
(length) (depth to top)			
<i>2"</i> <i>PVC</i>			
(size) (material)			
(6) pump <i>1</i> <i>8</i>			
(HP) (yield gpm)			
<i>electric</i>			
(type power)			
(7) electric log _____			
(yes or no)			
_____ (organization running log)			
(8) how well bottom plugged <i>Sand</i>			
<i>Mark</i>			
DRILLERS REMARKS:			


DEPT. OF NATURAL RESOURCES
BUREAU OF LAND & WATER RESOURCES

JAN 21 1983

RECEIVED

If well telescopes please sketch and show depths.

GROUND LEVEL

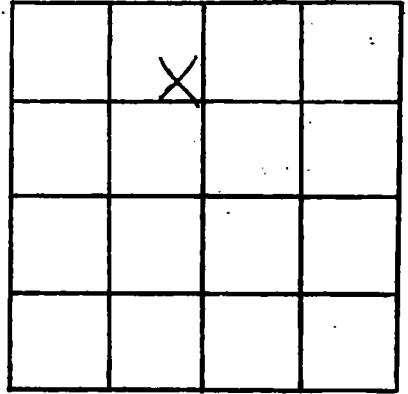

SECTION 32

Please indicate well location X.

ADDITIONAL INFORMATION

If more than one screen,
show locations of each on sketch.