

MISSISSIPPI DEPARTMENT OF NATURAL RESOURCES

Bureau of Land and Water Resources

Southport Mall

P.O. Box 10631

Jackson, Mississippi 39209

WATER WELL DRILLERS LOG

Harrison
E
2042

19 date well completed

firm name

county well located

Braden Pump & Well Sew, Inc. Harrison

LANDOWNER: Mary Dixon

description of formations encountered

from

to

Rt 2, Box 986

Pass Christian, Ms. 39571
(mailing address)

red clay	0	20
sand	20	40
white & blue clay	40	60
blue clay	60	80
clay	80	90
sand	90	95
clay	95	100
blue clay	100	120
blue clay	120	140
clay	140	160
sand	160	165
clay	165	220
sand	220	225
clay	225	380
sand	380	420

WELL LOCATION:

sec. 10 T 4 R 13 S W
12 miles N. of Osheola
(distance) (direction) (nearest town)

WELL PURPOSE: home
(home, irrigation, municipal, industrial)

WELL COMPLETION DATA:

(1) diameter (inches) 2"
(2) total depth (feet) 420
(3) static water level (feet) 90 below above top of ground.

(4) casing PVC, 405'
(material) (depth)

2" (size) if telescope see back.

(5) screen 10', 405'
(length) (depth to top)

2" PVC (size) (material)

(6) pump 1 (HP) 5 (yield gpm)

230V (type power)

(7) electric log no (yes or no)

(organization running log)

(8) how well bottom plugged PVC sand/shark

DRILLERS REMARKS: 5 ft tailpipe


DEPT. OF NATURAL RESOURCES
BUREAU OF LAND & WATER RESOURCES

JUN 13 1988

RECEIVED

If well telescopes please sketch and show depths.

GROUND LEVEL

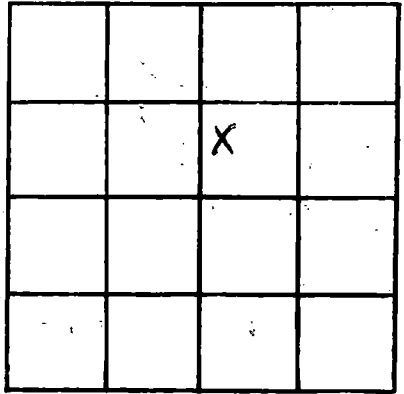

SECTION 10

Please indicate well location X.

ADDITIONAL INFORMATION

Lined area for additional information.

If more than one screen, show locations of each on sketch.