

MISSISSIPPI DEPARTMENT OF NATURAL RESOURCES

Bureau of Land and Water Resources

Southport Mall

P.O. Box 10631

Jackson, Mississippi 39209

WATER WELL DRILLERS LOG

Harrison
E
246

date well completed 3-24 1984 firm name M^o Neil Wells county well located Harrison

LANDOWNER: Laura Moran
Rt. 3 Box 177
Dpt. Mo. 39503
 (mailing address)

description of formations encountered	from	to
<u>Mud</u>	<u>0</u>	<u>20</u>
<u>band</u>	<u>40</u>	<u>80</u>
<u>Mud</u>	<u>80</u>	<u>120</u>
<u>band</u>	<u>120</u>	<u>200</u>
<u>Mud - band</u>	<u>200</u>	<u>220</u>
<u>Mud</u>	<u>220</u>	<u>280</u>
<u>fine sand</u>	<u>280</u>	<u>300</u>
<u>coarse sand</u>	<u>300</u>	<u>320</u>

WELL LOCATION:
 sec 30 T 6 N R 13 E
8 miles S of DeLude
 (distance) (direction) (nearest town)

WELL PURPOSE: Home
 (home, irrigation, municipal, industrial)

WELL COMPLETION DATA:

(1) diameter (inches) 4"

(2) total depth (feet) 320'

(3) static water level (feet) 60' below above top of ground.

(4) casing 5ch. 40 PVC 310'
 (material) (depth)
 (size) if telescope see back.

(5) screen 10' 310'
 (length) (depth to top)
4" sch. 40 PVC
 (size) (material)

(6) pump 1 25
 (HP) (yield gpm)
electric
 (type power)

(7) electric log yes or no
 (organization running log)

(8) how well bottom plugged good
level

DEPT. OF NATURAL RESOURCES
 BUREAU OF LAND & WATER RESOURCES


APR - 5 1984

RECEIVED

DRILLERS REMARKS:

If well telescopes please sketch and show depths.

GROUND LEVEL

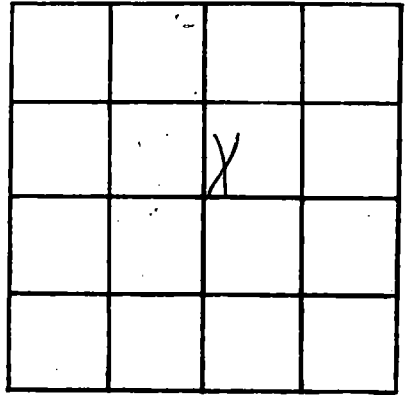

SECTION 30

Please indicate well location X.

ADDITIONAL INFORMATION

If more than one screen, show locations of each on sketch.