

MISSISSIPPI DEPARTMENT OF NATURAL RESOURCES

Bureau of Land and Water Resources

Southport Mall

P.O. Box 10631

Jackson, Mississippi 39209

WATER WELL DRILLERS LOG

Harrison
E
2050

10-30 date well completed

1985 Mc Hill Pump & Well firm name

Harrison county well located

LANDOWNER: R. Johnson  
112 Woodridge St.  
Saucier Ms.  
 (mailing address)

description of formations encountered	from	to
	Mud	0
Sand	10	30
Mud	30	90
Sand	90	130
Mud	130	510
Mud/Sand	510	540
Sand	540	600

WELL LOCATION:  
 sec. 1 T. 6 N. R. 13 E.  
1 miles E of Ligona  
 (distance) (direction) (nearest town)

WELL PURPOSE:  
 (home, irrigation, municipal, industrial)

- WELL COMPLETION DATA:
- (1) diameter (inches) 2"
  - (2) total depth (feet) 606'
  - (3) static water level (feet) 75' <sup>below</sup> <sub>above</sub> top of ground.
  - (4) casing Sch. 40 PVC, 590'  
 (material) (depth)  
 (size) If telescope see back.
  - (5) screen 10', 590'  
 (length) (depth to top)  
2", Sch. 80 PVC - 6 slot  
 (size) (material)
  - (6) pump 1, 8  
 (HP) (yield gpm)  
E Lec.  
 (type power)
  - (7) electric log \_\_\_\_\_  
 (yes or no)  
 \_\_\_\_\_  
 (organization running log)
  - (8) how well bottom plugged Sand  
SHARK


DRILLERS REMARKS:

RECEIVED  
 NOV 26 1985

Department of Natural Resources  
 Bureau of Land & Water Resources

If well telescopes please sketch and show depths.

GROUND LEVEL

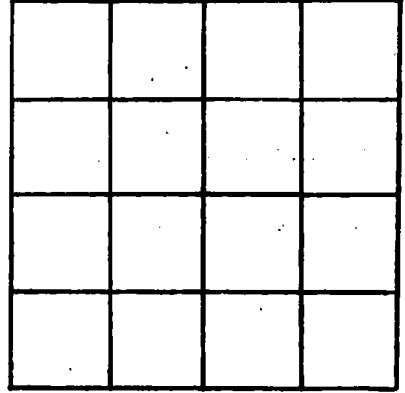

SECTION \_\_\_\_\_

Please indicate well location X.

ADDITIONAL INFORMATION

If more than one screen, show locations of each on sketch.