

MISSISSIPPI DEPARTMENT OF NATURAL RESOURCES
Bureau of Land and Water Resources
 Southport Mall
 P.O. Box 10631
 Jackson, Mississippi 39209
WATER WELL DRILLERS LOG

HARRISON
E 2051

3-19-86 19 McMill Pump & Wells Harrison
 date well completed firm name county well located

LANDOWNER Otis Biero
Rt #2 Box 834
Pass Chr. Mo.
 (mailing address)

description of formations encountered	from	to
1 mud	0	10
sand	10	60
1 mud	60	170
sand	170	210
1 mud	210	310
sand	310	350
1 mud	350	390
sand	390	460

WELL LOCATION:
 sec. 32 T. 6 N. R. 12 E
 S W
3 miles E of Hedon
 (distance) (direction) (nearest town)

WELL PURPOSE: Home
 (home, irrigation, municipal, industrial)

WELL COMPLETION DATA:

(1) diameter (inches) 2"

(2) total depth (feet) 460'

(3) static water level (feet) 90' ^{below} above top of ground.

(4) casing sch 40, 450'
 (material) (depth)

 if telescope see back.
 (size)

(5) screen 10, 450'
 (length) (depth to top)

2, sch 80 6 slot
 (size) (material)

(6) pump 1, 9
 (HP) (yield gpm)

elec
 (type power)

(7) electric log
 (yes or no)

 (organization running log)

(8) how well bottom plugged Seal


RECEIVED
MAR 28 1986

DRILLERS REMARKS:

Mississippi Department of Natural Resources
 Bureau of Land and Water Resources

If well telescopes please sketch and show depths.

GROUND LEVEL

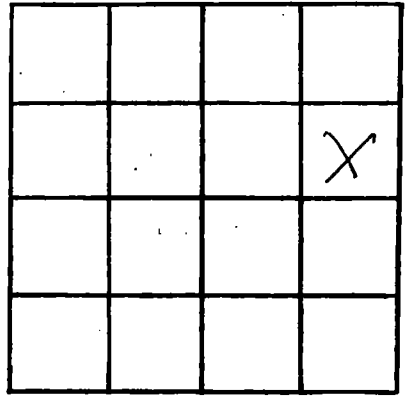

SECTION _____

Please indicate well location X.

ADDITIONAL INFORMATION

If more than one screen,
show locations of each on sketch.