

MISSISSIPPI DEPARTMENT OF NATURAL RESOURCES
Bureau of Land and Water Resources

P.O. Box 10631

Jackson, Mississippi 39209

WATER WELL DRILLERS LOG

COUNTY WELL LOCATED
Harrison

WELL NUMBER CODED
E 2053

DATE WELL COMPLETED
10-24-86

PERMIT NUMBER
023-9

NAME OF DRILLING FIRM
McAll Pump & Well

NAME & MAILING ADDRESS OF LANDOWNER
Cecil Ranier
Gulf Haven Rd.
Bog Beach Ms

WELL LOCATION: SEC _____ TOWNSHIP _____ RANGE _____
29 6 S R13W

DISTANCE _____ MILES DIRECTION _____ NEAREST TOWN _____
4 North of F10

OTHER LANDMARK
County Farm rd

WELL PURPOSE Home Irrigation, Municipal, Industrial, Fish Pond, etc.

PUMP DATA

PUMP TYPE (Circle One):
Submersible, Turbine, **Jet**, Flowing Well, Other (Describe) _____

POWER TYPE (Circle One):
Electric, Tractor, Diesel, Gasoline, Butane, Other (Describe) _____

Pump Capacity (GPM) _____ No. of Stages _____ Setting Depth _____
11 2 60' FT.

PUMP TEST
Well yielded _____ GPM with a drawdown of _____ ft. after _____ hours of pumping
11 5 1

WELL DATA

Well Depth 180'	Casing Diameter (In.) 2"	Casing Length (Ft.) 180'
Type of Casing PVC	Hole Depth 180	Depth to Static Water Level 30'

TYPE OF COMPLETION: (Circle One or More):
Gravel Packed, Underreamed, Telescoped, **Natural Development**, Open Hole, Other (Describe) _____

Top of Lap Pipe or Reduction in Casing _____ FEET IF TELESCOPED OR MORE THAN ONE SCREEN: USE BACK PAGE

LOG DATA

TYPE OF LOG RUN (Circle One):
Electric, Gamma Ray, Density, Sonic, Neutron, **No Log Run**, Other (Describe) _____

Name of Organization Running Log _____

SCREEN DATA

Diameter - Inches 2"	Length - Feet 10'	Slot Size - Inches 6-Thousandths
Screen Type PVC	Depth to Bottom - Feet 180'	

GEOLOGIC DATA (Office Use Only)

Surface Elev. _____	Geologic Unit _____	Unit Thickness _____	Depth to Top _____
Subs. SWL _____	Date _____	Analysis _____	Aquifer Test _____

Driller's Remarks _____

RECEIVED


DESCRIPTION OF FORMATIONS ENCOUNTERED	FROM	TO	FORMATIONS (If continued)	
			FROM	TO
Mud	0	30		
Sand	30	50		
mud	50	150		
Sand	150	180		
IF MORE SPACE IS NEEDED, USE BACK				

JAN 14 1987

Department of Natural Resources
Bureau of Land & Water Resources

If well telescopes please sketch and show depths.

GROUND LEVEL

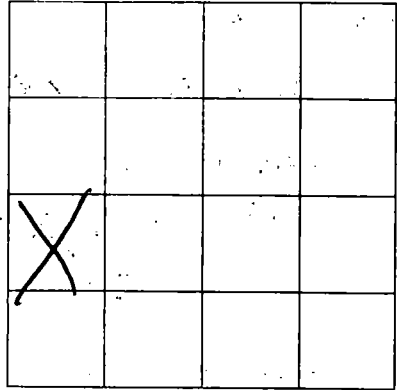

SECTION _____

Please indicate well location X.

ADDITIONAL INFORMATION

Lined area for additional information.

RECEIVED
NOV 1 1961
U.S. GEOLOGICAL SURVEY
WATER RESOURCES DIVISION
WASHINGTON, D.C.

If more than one screen, show location of each on sketch.