

MISSISSIPPI DEPARTMENT OF NATURAL RESOURCES
Bureau of Land and Water Resources

P.O. Box 10631
Jackson, Mississippi 39209
WATER WELL DRILLERS LOG

COUNTY WELL LOCATED <u>Harrison</u>	
WELL NUMBER <u>E 2057</u>	CODED
DATE WELL COMPLETED <u>Dec 26-86</u>	

PERMIT NUMBER <u>0239</u>
NAME OF DRILLING FIRM <u>REGILL PUMP & WELLS</u>
<u>RT1 BOX 1643 CANAL RD</u> <u>GUPT, MS 39503</u>

NAME & MAILING ADDRESS OF LANDOWNER <u>Beverly Allen</u> <u>01455 Pass Rd</u> <u>Gpt. ms</u>		
WELL LOCATION: SEC	TOWNSHIP	RANGE
<u>33</u>	<u>6</u>	<u>N 13 E</u>
DISTANCE	DIRECTION	NEAREST TOWN
<u>1</u> Miles	<u>East</u> of	<u>Deale</u>
OTHER LANDMARK		
WELL PURPOSE: <input checked="" type="radio"/> Home Irrigation, <input type="radio"/> Municipal, <input type="radio"/> Industrial, <input type="radio"/> Fish Pond, etc.		

PUMP DATA		
PUMP TYPE (Circle One): Submersible, Turbine, <input checked="" type="radio"/> Jet, Flowing Well, Other (Describe) <u>1hp str-site</u>		
POWER TYPE (Circle One): <input checked="" type="radio"/> Electric, Tractor, Diesel, Gasoline, Butane, Other (Describe)		
Pump Capacity (GPM) <u>13</u>	No. of Stages <u>2</u>	Setting Depth <u>20'</u> FT.
PUMP TEST		
Well yielded <u>13</u> GPM with a drawdown of <u>5</u> ft. after <u>1</u> hours of pumping		

WELL DATA		
Well Depth <u>540'</u>	Casing Diameter (In.) <u>2"</u>	Casing Length (Ft.) <u>540'</u>
Type of Casing <u>PVC</u>	Hole Depth <u>540</u>	Depth to Static Water Level <u>5'</u>
TYPE OF COMPLETION: (Circle One or More): <input checked="" type="radio"/> Gravel Packed, <input type="radio"/> Underreamed, <input type="radio"/> Telescoped, <input checked="" type="radio"/> Natural Development, <input type="radio"/> Open Hole, <input type="radio"/> Other (Describe)		
Top of Lap Pipe or Reduction in Casing <u>FEET</u> IF TELESCOPED OR MORE THAN ONE SCREEN: USE BACK PAGE		

LOG DATA	
TYPE OF LOG RUN (Circle One): Electric, Gamma Ray, Density, Sonic, <input checked="" type="radio"/> No Log Run, Other (Describe)	
Name of Organization Running Log	

SCREEN DATA		
Diameter - Inches	Length - Feet	Slot Size - Inches
Screen Type	Depth to Bottom - Feet	

GEOLOGIC DATA (Office Use Only)			
Surface Elev.	Geologic Unit	Unit Thickness	Depth to Top
Subs. SWL	Date	Analysis	Aquifer Test

Driller's Remarks

RECEIVED


DESCRIPTION OF FORMATIONS ENCOUNTERED	FROM	TO	FORMATIONS (Continued)	TO
<u>Mud</u>	<u>0</u>	<u>10</u>		
<u>Sand</u>	<u>10</u>	<u>70</u>		
<u>mud</u>	<u>70</u>	<u>200</u>		
<u>Sand</u>	<u>200</u>	<u>250</u>		
<u>mud</u>	<u>250</u>	<u>420</u>		
<u>Mud/Sand</u>	<u>420</u>	<u>500</u>		
<u>Sand</u>	<u>500</u>	<u>540</u>		
IF MORE SPACE IS NEEDED, USE BACK.				

JAN 14 1987

Department of Natural Resources
Bureau of Land & Water Resources

If well telescopes please sketch and show depths.

GROUND LEVEL

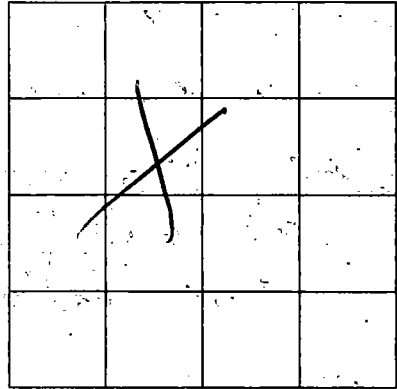

SECTION _____

Please indicate well location X.

ADDITIONAL INFORMATION

Multiple horizontal lines for additional information.

RECORD
1981

If more than one screen, show location of each on sketch.