

MISSISSIPPI DEPARTMENT OF NATURAL RESOURCES

Bureau of Land and Water Resources

Southport Mall

P.O. Box 10631

Jackson, Mississippi 39209

WATER WELL DRILLERS LOG

HARRISON
E 259

8-26-87 19
date well completed

R. J. Moore
firm name

HARRISON
county well located

LANDOWNER: **Carl Young**

VIDALIK RD

PAAS CHRISTIAN, MS
(mailing address)

WELL LOCATION:

sec. **30T 6 N** R. **2 E**
6 miles **N** of **KILM**
(distance) (direction) (nearest town)

WELL PURPOSE:

(home) Irrigation, municipal, industrial

WELL COMPLETION DATA:

- (1) diameter (Inches) **2"**
- (2) total depth (feet) **400**
- (3) static water level (feet) **50'** ^{below} _{above} top of ground.
- (4) casing **PVC**, **400'**
(material) (depth)
2" if telescope see back.
(size)
- (5) screen **10'**, **400'**
(length) (depth to top)
2", **PVC**
(size) (material)
- (6) pump **1**, **6**
(HP) (yield gpm)
Q
(type power)
- (7) electric log _____
(yes or no)

(organization running log)

(8) how well bottom plugged
BSW - 1/2"

description of formations encountered	from	to
red clay	0	40
red & white clay	40	100
Blue clay	100	350
med sand	350	360
coar. sand	360	400

RECEIVED


NOV 04 1987

Department of Natural Resources
Bureau of Land & Water Resources

DRILLERS REMARKS:

If well telescopes please sketch and show depths.

GROUND LEVEL

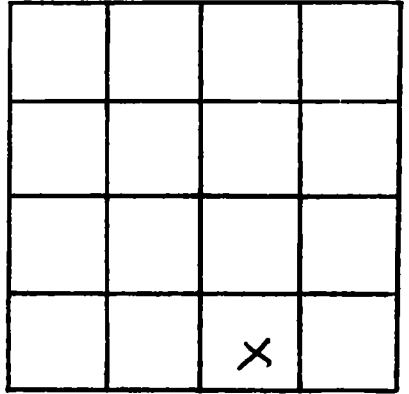

SECTION 30

Please indicate well location X.

ADDITIONAL INFORMATION

If more than one screen,
show locations of each on sketch.