

MISSISSIPPI DEPARTMENT OF NATURAL RESOURCES

Bureau of Land and Water Resources

P.O. Box 10631

Jackson, Mississippi 39209

WATER WELL DRILLERS LOG

COUNTY WELL LOCATED	
N Harrison	
WELL NUMBER	CODED
E 2060	
DATE WELL COMPLETED	
July 31-87	

PERMIT NUMBER
0239
NAME OF DRILLING FIRM
Medco Pump & Well
1643 Canal rd. #44

NAME & MAILING ADDRESS OF LANDOWNER		
John Curlo		
WELL LOCATION: SEC TOWNSHIP RANGE		
1 6 N 13 E		
DISTANCE	DIRECTION	NAREST TOWN
3 Miles	West	Bayona
OTHER LANDMARK		
WELL PURPOSE: <input checked="" type="checkbox"/> Home, <input type="checkbox"/> Irrigation, <input type="checkbox"/> Municipal, <input type="checkbox"/> Industrial, <input type="checkbox"/> Fish Pond, etc.		

PUMP DATA		
PUMP TYPE (Circle One):		
Submersible, Turbine, <input checked="" type="radio"/> Jet	Flowing Well, Other (Describe)	
POWER TYPE (Circle One):		
<input checked="" type="radio"/> Electric, Tractor, Diesel, Gasoline, Butane, Other (Describe)		
Pump Capacity (GPM)	No. of Stages	Setting Depth
12	2	100' FT.
PUMP TEST		
Well yielded 10 GPM with a drawdown of 10 ft. after 1 hours of pumping		

WELL DATA		
Well Depth	Casing Diameter (In.)	Casing Length (Ft.)
460	2"	450
Type of Casing	Hole Depth	Depth to Static Water Level
PVC	460	80'
TYPE OF COMPLETION: (Circle One or More):		
<input checked="" type="checkbox"/> Gravel Packed, <input type="checkbox"/> Underreamed, <input type="checkbox"/> Telescoped, <input checked="" type="checkbox"/> Natural Development, <input type="checkbox"/> Open Hole, <input type="checkbox"/> Other		
Top of Lap Pipe or Reduction in Casing		
FEET IF TELESCOPED OR MORE THAN ONE SCREEN: USE BACK PAGE		


LOG DATA	
TYPE OF LOG RUN (Circle One):	
<input checked="" type="radio"/> No Log Run, <input type="radio"/> Electric, <input type="radio"/> Gamma Ray, <input type="radio"/> Density, <input type="radio"/> Sonic, <input type="radio"/> Neutron, Other (Describe)	
Name of Organization Running Log	

SCREEN DATA		
Diameter - Inches	Length - Feet	Slot Size - Inches
2"	10'	.0006
Screen Type	Depth to Bottom - Feet	
PVC	460	

GEOLOGIC DATA (Office Use Only)			
Surface Elev.	Geologic Unit	Unit Thickness	Depth to Top
Subs. SWL	Date	Analysis	Aquifer Test


Driller's Remarks

DESCRIPTION OF FORMATIONS ENCOUNTERED	FROM	TO
Mud	0	60
Sand	60	100
Mud	100	120
Sand	120	220
Mud	220	420
Sand	420	460

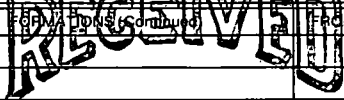 OCT 14 1987 Department of Natural Resources Bureau of Land & Water Resources	
IF MORE SPACE IS NEEDED, USE BACK	

If well telescopes please sketch and show depths.

GROUND LEVEL

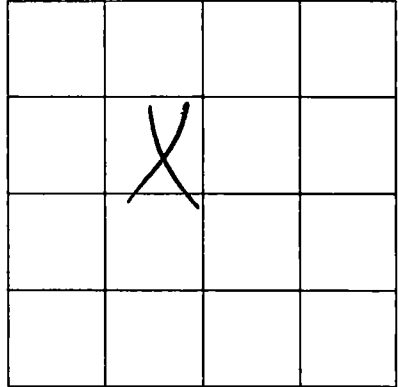

SECTION _____

Please indicate well location X.

ADDITIONAL INFORMATION

If more than one screen, show location of each on sketch.