

MISSISSIPPI DEPARTMENT OF NATURAL RESOURCES
Bureau of Land and Water Resources

P.O. Box 10631

Jackson, Mississippi 39209

WATER WELL DRILLERS LOG

COUNTY WELL LOCATED <u>Norfolk</u>
WELL NUMBER CODED <u>E 2062</u>
DATE WELL COMPLETED <u>7-22-87</u>

PERMIT NUMBER <u>0239</u>
NAME OF CONTRACTOR OR FIRM RTI BOX 1643 CANAL RD <u>GUPT, MS 39503</u>

NAME & MAILING ADDRESS OF LANDOWNER <u>Sam Anderson</u>			
WELL LOCATION: SEC <u>11</u> TOWNSHIP <u>6 N</u> RANGE <u>13 E</u>			
DISTANCE <u>2</u> Miles	DIRECTION <u>West</u> of	NEAREST TOWN <u>Superna</u>	
OTHER LANDMARK			
WELL PURPOSE: Home, Irrigation, Municipal, Industrial, Fish Pond, etc. <u>Home</u>			

PUMP DATA		
PUMP TYPE (Circle One): Submersible, Turbine, <input checked="" type="radio"/> Flowing Well, Other (Describe) <u>Well capped off</u>		
POWER TYPE (Circle One): <input checked="" type="radio"/> Electric, Tractor, Diesel, Gasoline, Butane, Other (Describe)		
Pump Capacity (GPM)	No. of Stages	Setting Depth FT.
PUMP TEST		
Well yielded _____ GPM with a drawdown of _____ ft. after _____ hours of pumping		

WELL DATA		
Well Depth <u>460'</u>	Casing Diameter (In.) <u>2"</u>	Casing Length (Ft.) <u>20</u>
Type of Casing <u>PVC</u>	Hole Depth <u>460'</u>	Depth to Static Water Level <u>40'</u>
TYPE OF COMPLETION: (Circle One or More): Gravel Packed, Underreamed, Telescoped, Natural Development, <input checked="" type="radio"/> Open Hole, Other		
Top of Lap Pipe or Reduction in Casing FEET IF TELESCOPED OR MORE THAN ONE SCREEN: USE BACK PAGE		

LOG DATA	
TYPE OF LOG RUN (Circle One): <input checked="" type="radio"/> No Log Run, Electric, Gamma Ray, Density, Sonic, Neutron, Other (Describe)	
Name of Organization Running Log	

SCREEN DATA		
Diameter - Inches <u>2"</u>	Length - Feet <u>10</u>	Slot Size - Inches <u>.0006</u>
Screen Type <u>PVC 50x80</u>	Depth to Bottom - Feet <u>460</u>	


GEOLOGIC DATA (Office Use Only)			
Surface Elev.	Geologic Unit	Unit Thickness	Depth to Top
Subs. SWL	Date	Analysis	Aquifer Test
Driller's Remarks			

DESCRIPTION OF FORMATIONS ENCOUNTERED	FROM	TO
<u>mud</u>	<u>0</u>	<u>100</u>
<u>Sand</u>	<u>100</u>	<u>140</u>
<u>mud</u>	<u>140</u>	<u>310</u>
<u>Sand</u>	<u>310</u>	<u>340</u>
<u>mud</u>	<u>340</u>	<u>380</u>
<u>Sand</u>	<u>380</u>	<u>440</u>

FORMATIONS (Continued)	FROM	TO
RECEIVED		
<u>OCT 14 1987</u>		
Department of Natural Resources Bureau of Land & Water Resources		
IF MORE SPACE IS NEEDED, USE BACK		

If well telescopes please
sketch and show depths.

GROUND LEVEL

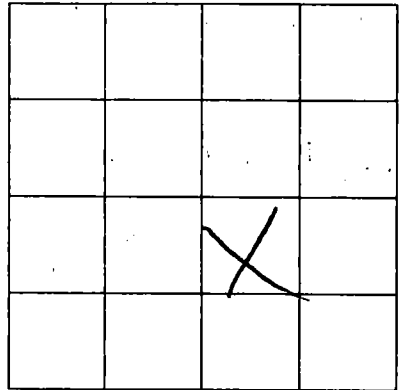

SECTION _____

Please indicate well location X.

ADDITIONAL INFORMATION

Lined area for additional information.

If more than one screen,
show location of each on sketch.