

**MISSISSIPPI DEPARTMENT OF NATURAL RESOURCES**  
Bureau of Land and Water Resources

P.O. Box 10631  
Jackson, Mississippi 39209  
**WATER WELL DRILLERS LOG**

COUNTY WELL LOCATED <i>Harrison</i>	
WELL NUMBER <i>E 2066</i>	CODED
DATE WELL COMPLETED <i>MAY-12-1988</i>	

PERMIT NUMBER <i>0239</i>
NAME OF DRILLING FIRM <i>McMill Pump &amp; Wells</i>

NAME & MAILING ADDRESS OF LANDOWNER <i>Glen Walker</i>		
<i>Rt 2, Box 12236</i>		
<i>Pass Christian MS.</i>		
WELL LOCATION: SEC	TOWNSHIP	RANGE
<i>32</i>	<i>6</i>	<i>N 13 E</i>
DISTANCE	DIRECTION	NEAREST TOWN
<i>6</i> Miles	<i>S 1/2</i>	of <i>Dadeaux</i>
OTHER LANDMARK		
WELL PURPOSE: <input checked="" type="checkbox"/> Home <input type="checkbox"/> Irrigation, Municipal, Industrial, Fish Pond, etc.		

<b>PUMP DATA</b>		
PUMP TYPE (Circle One): Submersible, Turbine, <input checked="" type="checkbox"/> <b>Jet</b> Flowing Well, Other (Describe) _____		
POWER TYPE (Circle One): <input checked="" type="checkbox"/> <b>Electric</b> Tractor, Diesel, Gasoline, Butane, Other (Describe) _____		
Pump Capacity (GPM) <i>13</i>	No. of Stages <i>2</i>	Setting Depth <i>80'</i> FT.
PUMP TEST		
Well yielded <i>9</i> GPM with a drawdown of <i>10</i> ft. after <i>1</i> hours of pumping		

<b>WELL DATA</b>		
Well Depth <i>440'</i>	Casing Diameter (In.) <i>2"</i>	Casing Length (Ft.) <i>430'</i>
Type of Casing <i>PVC</i>	Hole Depth <i>440'</i>	Depth to Static Water Level <i>60'</i>
TYPE OF COMPLETION: (Circle One or More): <input checked="" type="checkbox"/> Gravel Packed, <input type="checkbox"/> Underreamed, <input type="checkbox"/> Telescoped, <input checked="" type="checkbox"/> <b>Natural Development</b> , <input type="checkbox"/> Open Hole, <input type="checkbox"/> Other (Describe) _____		
Top of Lap Pipe or Reduction in Casing <b>FEET</b> IF TELESCOPED OR MORE THAN ONE SCREEN: USE BACK PAGE		

<b>LOG DATA</b>	
TYPE OF LOG RUN (Circle One): Electric, Gamma Ray, Density, Sonic, <input checked="" type="checkbox"/> <b>No Log Run</b> , Neutron, Other (Describe) _____	
Name of Organization Running Log	

<b>SCREEN DATA</b>		
Diameter - Inches <i>2"</i>	Length - Feet <i>10'</i>	Slot Size - Inches <i>.0004</i>
Screen Type <i>PVC</i>	Depth to Bottom - Feet <i>440'</i>	


<b>GEOLOGIC DATA (Office Use Only)</b>			
Surface Elev.	Geologic Unit	Unit Thickness	Depth to Top
Subs. SWL	Date	Analysis	Aquifer Test
Driller's Remarks			

DESCRIPTION OF FORMATIONS ENCOUNTERED	FROM	TO	FORMATIONS (Continued)	FROM	TO
<i>mud</i>	<i>0</i>	<i>10</i>	<b>RECEIVED</b>  <i>JUN 17 1988</i>  <i>Department of Natural Resources Bureau of Land &amp; Water Resources</i>		
<i>sand</i>	<i>10</i>	<i>20</i>			
<i>mud</i>	<i>20</i>	<i>390</i>			
<i>sand</i>	<i>390</i>	<i>440</i>			

IF MORE SPACE IS NEEDED, USE BACK

If well telescopes please sketch and show depths.

GROUND LEVEL

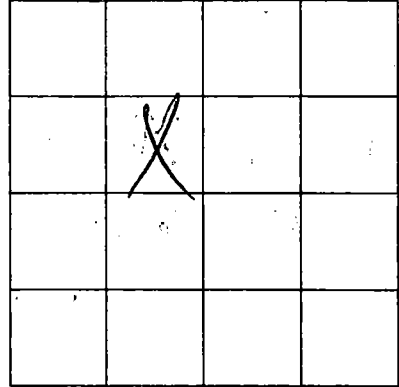

SECTION \_\_\_\_\_

Please indicate well location X.

ADDITIONAL INFORMATION

If more than one screen,  
show location of each on sketch.