

MISSISSIPPI DEPARTMENT OF NATURAL RESOURCES

Bureau of Land and Water Resources

P.O. Box 10631

Jackson, Mississippi 39209

WATER WELL DRILLERS LOG

COUNTY WELL LOCATED
Harrison

WELL NUMBER *E 2070*

DATE WELL COMPLETED
6-3-89

PERMIT NUMBER
0-493

NAME OF DRILLING FIRM
Bobby Beech's

Well Works

NAME & MAILING ADDRESS OF LANDOWNER
Nathan Cuevas

29473 N. Ladner Rd

P.C. MS

WELL LOCATION: SEC *22* TOWNSHIP *6* RANGE *N 13 E* W

DISTANCE _____ MILES _____ OF _____

DIRECTION _____

NEAREST TOWN _____

OTHER LANDMARK _____

WELL PURPOSE: ~~Home~~ Irrigation, Municipal, Industrial, Fish Pond, etc.

PUMP DATA

PUMP TYPE (Circle One):
Submersible, Turbine, Jet, Flowing Well,
Other (Describe) _____

POWER TYPE (Circle One):
 Electric, Tractor, Diesel, Gasoline, Butane,
Other (Describe) _____ H/P _____

Pump Capacity (GPM)	No. of Stages	Setting Depth
	<i>2</i>	_____ FT.

PUMP TEST

Well yielded _____ GPM with
a drawdown of _____ ft.
after _____ hours of pumping

WELL DATA

Well Depth	Casing Diameter (In.)	Casing Length (Ft.)
<i>261</i>	<i>2"</i>	<i>20</i>
Type of Casing	Hole Depth	Depth to Static Water Level
<i>PVC</i>	<i>261</i>	<i>26</i>

TYPE OF COMPLETION: (Circle One or More):
Gravel Packed, Underreamed, Telescoped,
 Natural Development, Open Hole, Other _____

Top of Lap Pipe or Reduction in Casing

FEET IF TELESCOPED OR MORE THAN ONE SCREEN: USE BACK PAGE

LOG DATA

TYPE OF LOG RUN (Circle One):
Electric, Gamma Ray, Density, Sonic, Neutron,
Other (Describe) _____

No Log Run

Name of Organization Running Log
Bobby Beech's Well Works

GEOLOGIC DATA (Office Use Only)

Surface Elev.	Geologic Unit	Unit Thickness	Depth to Top
Subs. SWL	Date	Analysis	Aquifer Test

SCREEN DATA

Diameter - Inches	Length - Feet	Slot Size - Inches
<i>2"</i>	<i>20</i>	<i># 8</i>
Screen Type	Depth to Bottom - Feet	
<i>Johnson Screens</i>	<i>261</i>	

Driller's Remarks
Fine Well


DESCRIPTION OF FORMATIONS ENCOUNTERED	FROM	TO

FORMATIONS (Continued)	FROM	TO
RECEIVED		
JUN 6 1989		
Department of Natural Resources Bureau of Land & Water Resources		

IF MORE SPACE IS NEEDED, USE BACK

If well telescopes please sketch and show depths.

GROUND LEVEL

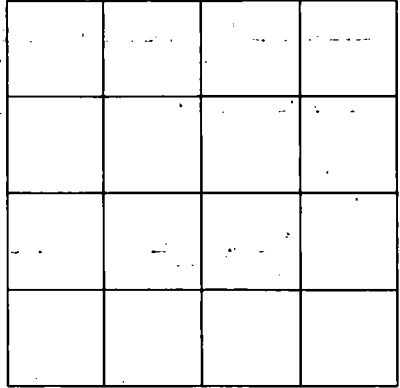

SECTION _____

Please indicate well location X.

ADDITIONAL INFORMATION

RECEIVED
DIVISION

NOV 8 1951

CONSERVATION DEPARTMENT
WATER RESOURCES DIVISION

If more than one screen,
show location of each on sketch.