

MISSISSIPPI DEPARTMENT OF ENVIRONMENTAL QUALITY
Bureau of Land and Water Resources

P. O. Box 10631
Jackson, MS 39289-0631
WATER WELL DRILLERS LOG

COUNTY WELL LOCATED
HARRISON
WELL NUMBER
E 2086
CODING
DATE WELL COMPLETED
9-14-93

PERMIT NUMBER
0404
NAME OF DRILLING FIRM
Hyman Well Co.
Support no. 39503

NAME & MAILING ADDRESS OF LANDOWNER
Jeffrey Swilley
Cemetery Rd.
Support Ms 39503
WELL LOCATION: SEC TOWNSHIP RANGE
26 6 ^N 13 ^W
DISTANCE _____ MILES _____ OF _____
DIRECTION _____
NEAREST TOWN _____
OTHER LANDMARK _____
WELL PURPOSE <input checked="checked" type="radio"/> Home Irrigation, Municipal, Industrial, Fish Pond, etc.

PUMP DATA
PUMP TYPE (Circle One): Submersible, Turbine, Jet, Flowing Well, Other (Describe) _____
POWER TYPE (Circle One): Electric, Tractor, Diesel, Gasoline, Butane, Other (Describe) _____ H/P _____
Pump Capacity (GPM) _____ No. of Stages _____ Setting Depth _____ FT.
PUMP TEST
Well yielded _____ GPM with a drawdown of _____ ft. after _____ hours of pumping


WELL DATA
Well Depth _____ Casing Diameter (In.) _____ Casing Length (Ft.) _____
147' 2" _____
Type of Casing _____ Hole Depth _____ Depth to Static Water Level _____
PVC _____
TYPE OF COMPLETION: (Circle One or More): Gravel Packed, Underreamed, Telescoped, Natural Development, Open Hole, Other (Describe) _____
Top of Lap Pipe or Reduction in Casing _____
FEET IF TELESCOPED OR MORE THAN ONE SCREEN: USE BACK PAGE

LOG DATA
TYPE OF LOG RUN (Circle One): No Log Run, Electric, Gamma Ray, Density, Sonic, Neutron, Other (Describe) _____
Name of Organization Running Log _____

SCREEN DATA
Diameter - Inches _____ Length - Feet _____ Slot Size - Inches _____
2" 10' _____
Screen Type _____ Depth to Bottom - Feet _____
PVC _____

GEOLOGIC DATA (Office Use Only)			
Surface Elev.	Geologic Unit	Unit Thickness	Depth to Top
Subs. SWL	Date	Analysis	Aquifer Test


Driller's Remarks

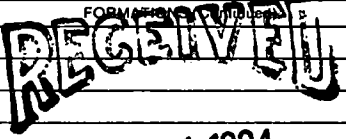DESCRIPTION OF FORMATIONS ENCOUNTERED	FROM	TO	FORMATIONS ENCOUNTERED	FROM	TO	
			 MAR 21 1994 Dept. of Environmental Quality Bureau of Land & Water Resources			

IF MORE SPACE IS NEEDED, USE BACK

If well telescopes please
sketch and show depths.

GROUND LEVEL

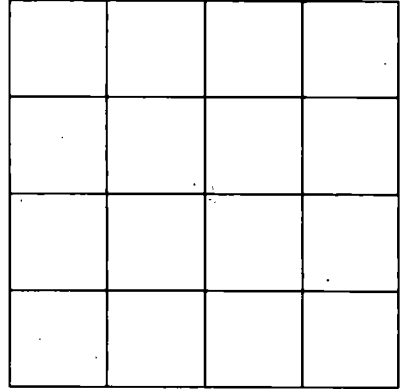

SECTION _____

Please indicate well location X.

ADDITIONAL INFORMATION

Handwritten notes:
APPROX. 3. 7. 2. 5. 1. 0. 4.

Handwritten notes:
Vertical of boundary line to left of road & north of road.

If more than one screen,
show location of each on sketch.