


If well telescopes please sketch and show depths.

GROUND LEVEL

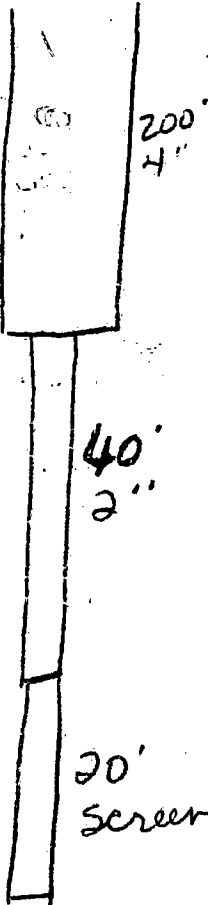

20' Screen

If more than one screen, show location of each on sketch.

30	3000	3000	
60	3000	3000	
90	3000	3000	
120	3000	3000	

SECTION _____

Please indicate well location X.

Pump Capacity (GPM)	No. of Stages	Setting Depth
18	8	120" FT.
PUMP TEST		
Well yielded <u>18</u> GPM with a drawdown of <u>10</u> ft. after <u>12</u> hours of pumping		

LOG DATA

TYPE OF LOG RUN (Circle One): No Log Run
 Electric, Gamma Ray, Density, Sonic, Neutron, Other (Describe) _____

Name of Organization Running Log _____

GEOLOGIC DATA (Office Use Only)

Surface Elev.	Geologic Unit	Unit Thickness	Depth to Top
Subs. SWL	Date	Analysis	Aquifer Test

Driller's Remarks
