


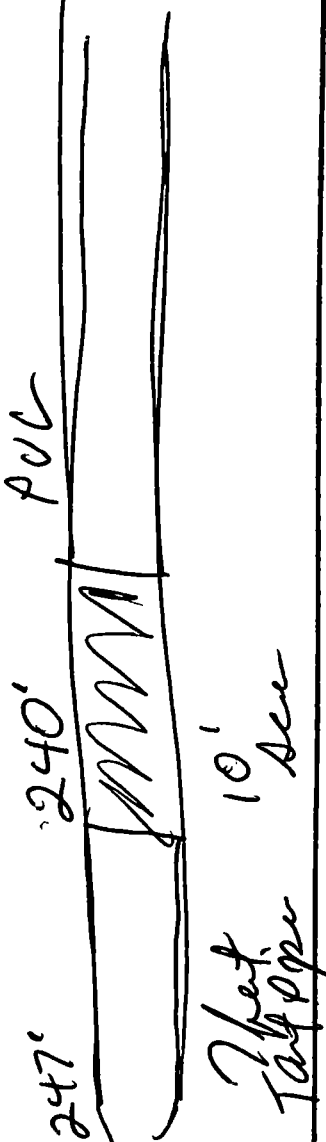

If well telescopes please sketch and show depths.

GROUND LEVEL



X			

SECTION 12

Please indicate well location X.

Pump Capacity (GPM)	No. of Stages	Setting Depth	FT.
1 HP	2	80	

PUMP TEST

Well yielded 4 1/2 GPM with  
a drawdown of \_\_\_\_\_ ft.  
after \_\_\_\_\_ hours of pumping

LOG DATA

TYPE OF LOG RUN (Circle One): No Log Run, Electric, Gamma Ray, Density, Sonic, Neutron, Other (Describe) \_\_\_\_\_

Name of Organization Running Log \_\_\_\_\_

GEOLOGIC DATA (Office Use Only)

Surface Elev.	Geologic Unit	Unit Thickness	Depth to Top
Subs. SWL	Date	Analysis	Aquifer Test

Driller's Remarks

If more than one screen, show location of each on sketch.