

Harrison
F 9
5-68

MISSISSIPPI
BOARD OF WATER COMMISSIONERS
416 North State Street
Jackson, Mississippi 39201

CODED

WATER WELL DRILLERS LOG

5-13 1968 C.T. Switzer Well Co. Harrison
date well completed Firm name county well located


LANDOWNER: <u>Jerry L. Geil</u>	description of formations encountered	from	to
<u>Route 3 Menonite Road</u>	<u>clay</u>	<u>0</u>	<u>42</u>
<u>Support, Miss</u>	<u>miled</u>	<u>42</u>	<u>62</u>
(mailing address)	<u>fine sand</u>	<u>62</u>	<u>83</u>
	<u>sand</u>	<u>83</u>	<u>92</u>
WELL LOCATION:	<u>clay</u>	<u>92</u>	<u>103</u>
sec <u>29</u> T. <u>2</u> S. R. <u>12</u> W.	<u>miled</u>	<u>103</u>	<u>123</u>
<u>8 1/2</u> miles <u>W</u> of <u>WYMAN</u>	<u>fine sand</u>	<u>123</u>	<u>144</u>
(distance) (direction) (nearest town)	<u>good sand</u>	<u>144</u>	<u>174</u>
WELL PURPOSE: <u>None</u>	<u>clay</u>	<u>174</u>	<u>196</u>
(home, irrigation, municipal, industrial)	<u>good sand</u>	<u>196</u>	<u>242</u>
WELL COMPLETION DATA:	<u>clay</u>	<u>242</u>	<u>289</u>
(1) diameter (inches) <u>2 x 4</u>	<u>miled</u>	<u>289</u>	<u>310</u>
(2) total depth (feet) <u>635</u>	<u>good sand</u>	<u>310</u>	<u>342</u>
(3) static water level (feet) <u>49</u> below top of ground.	<u>clay</u>	<u>342</u>	<u>361</u>
(4) casing <u>gal steel 615'</u> (material) (depth)	<u>sand</u>	<u>361</u>	<u>372</u>
<u>2 x 4</u> If telescope see back. (size)	<u>clay</u>	<u>372</u>	<u>393</u>
(5) screen <u>20'</u> (length) <u>615'</u> (depth to top)	<u>miled</u>	<u>393</u>	<u>412</u>
<u>8 ga. 55 in. pipe</u> (size) (material)	<u>clay</u>	<u>412</u>	<u>450</u>
(6) pump <u>1 1/2</u> (HP) <u>14</u> (yield gpm)	<u>miled</u>	<u>450</u>	<u>487</u>
<u>electric</u> (type power)	<u>clay</u>	<u>487</u>	<u>505</u>
(7) electric log <u>No</u> (yes or no)	<u>sand</u>	<u>505</u>	<u>509</u>
(organization running log)	<u>miled</u>	<u>509</u>	<u>572</u>
(8) how well bottom plugged <u>Back pressure valve</u>	<u>fair sand</u>	<u>572</u>	<u>593</u>
DRILLERS REMARKS:	<u>good sand</u>	<u>593</u>	<u>616</u>
	<u>sand gravel</u>	<u>616</u>	<u>636</u>

CODED

JUL 8 1968
WATER WELL DIV
MISSISSIPPI

If well telescopes please sketch and show depths.

GROUND LEVEL

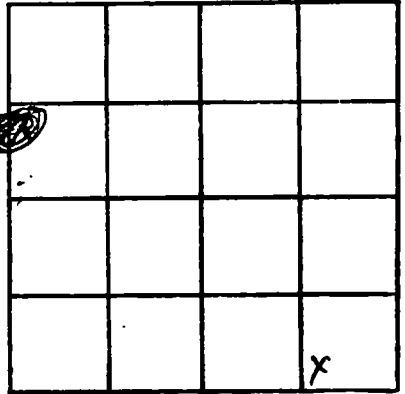

SECTION 29

Please indicate well location X.

ADDITIONAL INFORMATION

If more than one screen, show locations of each on sketch.