

WATER WELL DRILLERS

**CODED**

C  
K-313

HAR. OF 11  
Date: Apr 6, 1961 Driller: Joe Miller County Harrison  
4-61 (Name)

(1) Owner of Land: Mrs Zora Bleasdale  
(Name)  
R R # 1  
(Address)  
Laurie Miss

(2) Location: NW 1/4, NW 1/4, Sec. 1 T. 5 R. 2  
20 miles N.W. of Sulfur  
(distance) (direction) (Nearest Town)

(3) Topography: Hilly  
(Hilly) (Flat) (Level)

(4) Purpose of Well: Domestic  
(Domestic Irrigation  
Municipal, Industrial, Other)

Description & Color of Materials Sand, Clay, Red Clay, Shell, etc.	Thick- ness Feet	Depth Feet
Red Sandy Clay		25
Red Cl.	23	48
White Mottled Clay	109	157
Bl. Clay	10	167
Bl. Br. Sands.	21	188
Bl. Cl. small Br.	189	377
hd. Bl. Cl.	38	415
Fine Gr. Sand	4	419
Grumie	13	432
Sand. Fine	8	440
Sand. Good	11	451
Sand. Good	3	454
hd. Cl.	1	455

Information upon completion of well:

(1) Diameter: 2 inches.

(2) Total Depth: 455 feet.

(3) Water Level: 52' feet below top of ground.

(4) Cased to: 444, Size 2"

(5) Screen: Size 2", Length 10'


(6) Were any formations sealed against pollution?  
yes, C no.

**CODED**

If YES depth of formation \_\_\_\_\_

Why \_\_\_\_\_

Drillers Remarks: Pumping 1700 G.P.H. Air

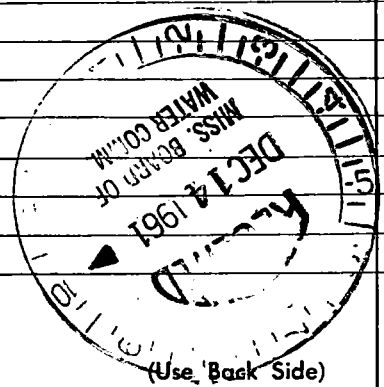

Well No.

S

Little Belge  
River

add Hwy 49

well

Wortham Rd.

Big Belge  
River

N