

HARRISON
F 12
3-1-71

MISSISSIPPI
 BOARD OF WATER COMMISSIONERS
 416 North State Street
 Jackson, Mississippi 39201
WATER WELL DRILLERS LOG

CODED

3-1-71 19
 date well completed

R. J. Moore
 firm name

HARRISON
 county well located

LANDOWNER: Keith Turney

description of formations encountered

from

to

Shaw RD

Gulfport, Miss
 (mailing address)

WELL LOCATION:

sec. 15 T. 6 N. R. 12 E.
 (distance) miles (direction) of LYMAN
 (nearest town)

WELL PURPOSE:

(home) irrigation, municipal, industrial

WELL COMPLETION DATA:

- (1) diameter (inches) 2"
- (2) total depth (feet) 306
- (3) static water level (feet) 85' ^{below} / _{above} top of ground.
- (4) casing Shaw 294'
 (material) (depth)
 (size) if telescope see back.
- (5) screen 2x10 294'
 (length) (depth to top)
2" SS
 (size) (material)
- (6) pump _____
 (HP) (yield gpm)
 (type power)
- (7) electric log _____
 (yes or no)
 (organization running log)
- (8) how well bottom plugged Bad
NAWC

DRILLERS REMARKS:


CODED

MAR 29 1971

MISS. BD. OF
 WATER COM.

If well telescopes please sketch and show depths.

GROUND LEVEL

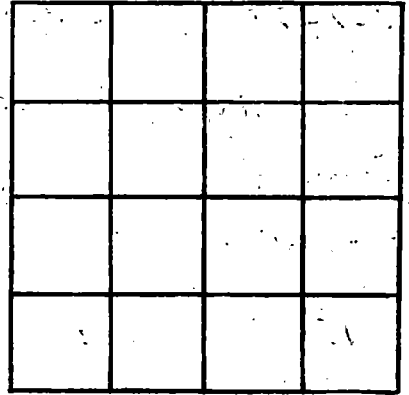

SECTION _____

Please indicate well location X.

ADDITIONAL INFORMATION

If more than one screen, show locations of each on sketch.