

HAR.

MISSISSIPPI BOARD OF WATER COMMISSIONERS

F 19

4713203

**CODED**

12-19-60

WATER WELL DRILLERS LOG

7-500

Date: 12-19, 1960, Driller: Hattiesburg County Harrison

(Name)

(1) Owner of Land: Harold H. Hoskins

(Name)

Route 2 Gulfport

(Address)

(2) Location: 1/4, 1/4, Sec. 26 T 6 R 12

10 miles NW of Hatt

(distance)

(direction)

(Nearest Town)

(3) Topography: X

(Hilly)

(Flat)

(Level)

(4) Purpose of Well: domestic

(Domestic Irrigation  
Municipal, Industrial, Other)


Description & Color of Materials  
Sand, Clay, Red Clay, Shell, etc.

Thick-  
ness  
Feet

Depth  
Feet

Red clay	0-50
Red sand	50-60
white clay	60-80
Blue clay	80-150
Blue sand	150-180

**CODED**

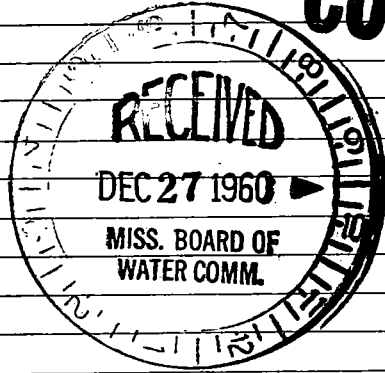

Information upon completion of well:

- (1) Diameter 2 inches.
- (2) Total Depth 180 feet.
- (3) Water Level 72 feet below top of ground.
- (4) Cased to \_\_\_\_\_, Size \_\_\_\_\_
- (5) Screen: Size 2", Length 10'
- (6) Were any formations sealed against pollution?  
\_\_\_\_\_ yes, X no.

If YES depth of formation \_\_\_\_\_

Why \_\_\_\_\_

Drillers' Remarks: \_\_\_\_\_

(Use Back Side)

Well No.

