

HAR. F-25
10-20-61

CODED

F-302

WATER WELL DRILLERS LOG

Date: 10-20, 1961, Driller: Sutton Well Wks. County Harrison

(Name)

- (1) Owner of Land: BOSWORTH HOMES
(Name)
Rt. 1 Gulfport, Miss.
(Address)
- (2) Location: SW 1/4, SW 1/4, Sec. 18 T6SR12, W
2 miles SSE of LIZANA,
(distance) (direction) (Nearest Town)
- (3) Topography: hilly
(Hilly) (Flat) (Level)
- (4) Purpose of Well: domestic
(Domestic Irrigation
Municipal, Industrial, Other)

Description & Color of Materials Sand, Clay, Red Clay, Shell, etc.	Thick- ness Feet	Depth Feet
Clay	12	12
sand	16	28
Clay	128	156
sand	44	200
Clay	180	380
sand	44	424


Information upon completion of well:

- (1) Diameter 2 inches.
- (2) Total Depth 424 feet.
- (3) Water Level 72 feet below top of ground.
- (4) Cased to all, Size 2"
- (5) Screen: Size 2, Length 10'
- (6) Were any formations sealed against pollution?
no

If YES depth of formation _____

Why _____

Drillers Remarks: _____

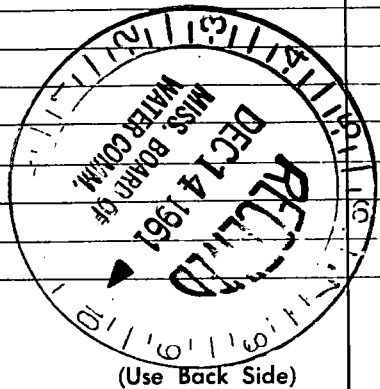

Well No. _____

100

100

