

MISSISSIPPI BOARD OF WATER COMMISSIONERS

HAR.  
F 24  
5-11-62

WATER WELL DRILLERS LOG

**CODED**

Date: 5-11, 1962, Driller: Sutter Well Works County Harrison  
(Name)

	Description & Color of Materials Sand, Clay, Red Clay, Shell, etc.	Thick- ness Feet	Depth Feet
(1) Owner of Land: <u>K A Neely</u> (Name)	<u>Clay</u>	<u>15</u>	<u>15</u>
<u>Rt 2</u> (Address) <u>Gulfport</u>	<u>red sand</u>	<u>25</u>	<u>40</u>
(2) Location: <u>NW 1/4, NW 1/4, Sec. 34 T6SR12W</u>	<u>Clay</u>	<u>130</u>	<u>170</u>
<u>12</u> miles <u>N</u> of <u>Pan Christian</u> (distance) (direction) (Nearest Town)	<u>sand</u>	<u>25</u>	<u>195</u>
(3) Topography: <u>Hilly</u> (Hilly) (Flat) (Level)	<u>Clay</u>	<u>155</u>	<u>350</u>
(4) Purpose of Well: <u>domestic</u> (Domestic Irrigation Municipal, Industrial, Other)	<u>sand</u>	<u>30</u>	<u>380</u>

**CODED**


Information upon completion of well:

- (1) Diameter 2 inches.
- (2) Total Depth 380 feet.
- (3) Water Level 65 feet below top of ground.
- (4) Cased to cell, Size 2"
- (5) Screen: Size 2", Length 5'
- (6) Were any formations sealed against pollution?  
 yes,  no.

If YES depth of formation \_\_\_\_\_

Why \_\_\_\_\_

Drillers Remarks: \_\_\_\_\_

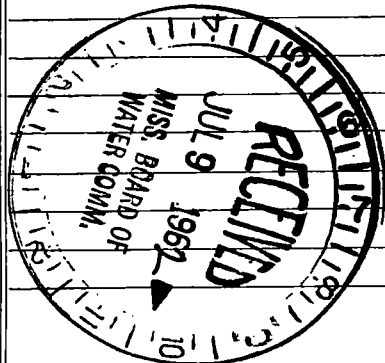

(Use Back Side)

Well No. \_\_\_\_\_

2-11

Handwritten header text, possibly a date or reference number.

Vertical handwritten notes on the left side of the page.

Main body of handwritten text, including what appears to be a signature and several lines of notes.

Small handwritten mark or number.

Small handwritten mark or number.

