

HAR.
F 27
8-15-62

WATER WELL DRILLERS LOG

5
CODED

Date: Aug 15, 1962, Driller: Mo B Drilling Co Harrison
(Name)

- (1) Owner of Land: Lee Quality Home
(Name)
Crestmont Miss
(Address)
- (2) Location: SW 1/4, NW 1/4, Sec 23 T8R12W
4 miles West, of Lyman
(distance) (direction) (Nearest Town)
- (3) Topography: Slightly Rolling
(Hilly) (Flat) (Level)
- (4) Purpose of Well: Domestic
(Domestic Irrigation
Municipal, Industrial, Other)

Description & Color of Materials Sand, Clay, Red Clay, Shell, etc.	Thick- ness Feet	Depth Feet
White Clay-Brown	40	40
White Clay	130	170
Brownish Red Sand	45	215
Blue Clay - 215 on		
There were no sand breaks from top of ground to the sand.		

Information upon completion of well:


- (1) Diameter 2 inches.
- (2) Total Depth 213 feet.
- (3) Water Level 80 feet below top of ground.
- (4) Cased to 208, Size 2"
- (5) Screen: Size 8 5/16" X 2", Length 5 FT.
- (6) Were any formations sealed against pollution?
_____ yes, _____ no.

If YES depth of formation _____

Why _____

Drillers Remarks: _____

CODED

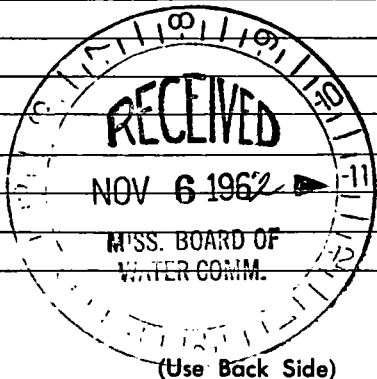

Well No.

