

HAR. MISSISSIPPI BOARD OF WATER COMMISSIONERS

F

F 28

8-16-62

WATER WELL DRILLERS LOG

CODED

Date: Aug 16, 1962, Driller: M & B Drilling Co. County Harris
(Name)

(1) Owner of Land: Lee Quality Homes
(Name)
Georgetown, Miss.
(Address)

(2) Location: SW 1/4, NW 1/4, Sec. 23 65 12 W
4 miles West of Hyman
(distance) (direction) (Nearest Town)

(3) Topography: Rolling
(Hilly) (Flat) (Loamy)

(4) Purpose of Well: Domestic
(Domestic Irrigation Municipal, Industrial, Other)

Description & Color of Materials Sand, Clay, Red Clay, Shell, etc.	Thick- ness Feet	Depth Feet
Clay	12	12
White sand & small gravel	76	88
White Clay	97	185
Brownish Red sand	29	214
Blue Clay	214 on	

This well across a ravine from other well for same purpose. Drilling all together different in top 200 ft.

Information upon completion of well:

(1) Diameter 2 inches.

(2) Total Depth 213 feet.

(3) Water Level 73 feet below top of ground.

(4) Cased to 208, Size 2"

(5) Screen: Size 8-16/32", Length 5 FT


(6) Were any formations sealed against pollution?
 _____ yes, _____ no.

CODED

If YES depth of formation _____

Why _____

Drillers Remarks: _____

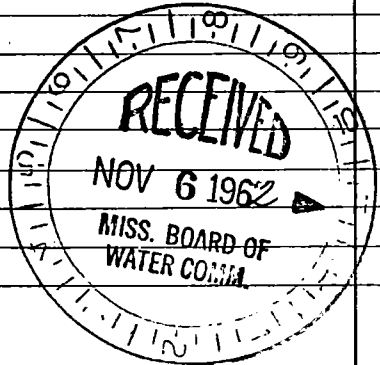

(Use Back Side)

Well No.

