

HAR.

MISSISSIPPI BOARD OF WATER COMMISSIONERS

F

F 3)
10-4-62

WATER WELL DRILLERS LOG

CODED

Date: Oct 4, 1962, Driller: M & B Drilling Co. County Harrison
(Name)

(1) Owner of Land: Ollie Odem
(Name)
A. P. Saucier, Miss
(Address)

(2) Location: NE 1/4, NW 1/4, Sec. 5 65.42W
2 miles N.E. of Lizana
(distance) (direction) (Nearest Town)

(3) Topography: Hilly
(Hilly) (Flat) (Level)

(4) Purpose of Well: Domestic
(Domestic Irrigation
Municipal, Industrial, Other)

Description & Color of Materials Sand, Clay, Red Clay, Shell, etc.	Thick- ness Feet	Depth Feet
White Clay	60	60
Brown-Red Sand	47	107
Yellow Clay	5	112
Blue Clay	154	266
Fine Sand	20	286
Blue Clay	107	390
Coarse Grey Sand	40	430
Blue Clay	430m	

Information upon completion of well:

(1) Diameter 2" inches.

(2) Total Depth 425 feet.

(3) Water Level 48 feet below top of ground.

(4) Cased to 415, Size 2"

(5) Screen: Size 8 1/2 x 2", Length 10 FT.


(6) Were any formations sealed against pollution?
_____ yes, _____ no.

CODED

If YES depth of formation _____

Why _____

Drillers Remarks: _____

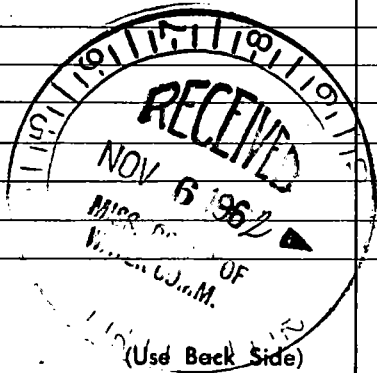

Well No.

1000

Handwritten notes, possibly a list or ledger, with various entries and numbers.

Extensive handwritten notes and calculations, including a large table or ledger with multiple columns and rows of data.