

F32
12-3-62

WATER WELL DRILLERS LOG

CODED

Date: Dec 3, 1962, Driller: M & B Drilling Co County Harrison
(Name)

- (1) Owner of Land: Julius J. Cuevas
(Name)
Rt. 1 Box 112, Jaucier, Miss.
(Address)
- (2) Location: NW 1/4, SW 1/4, Sec. 4 T-5R24
4 miles West, of Wentham,
(distance) (direction) (Nearest Town)
- (3) Topography: Hilly
(Hilly) (Flat) (Level)
- (4) Purpose of Well: Domestic
(Domestic Irrigation
Municipal, Industrial, Other)

Description & Color of Materials
Sand, Clay, Red Clay, Shell, etc.

Thick-
ness
Feet

Depth
Feet

We washed this well down a hole that a seismograph company drilled to 70 ft. for him.
good supply of water but will be messy as sand is a brown sand.

Information upon completion of well:


- (1) Diameter 2 inches.
- (2) Total Depth 68 feet.
- (3) Water Level 23 feet below top of ground.
- (4) Cased to 63, Size 2"
- (5) Screen: Size 1/4 X 60 gauge, Length 5 FT.
- (6) Were any formations sealed against pollution?
_____ yes, _____ no.

If YES depth of formation _____

Why _____

Drillers Remarks: _____

CODED

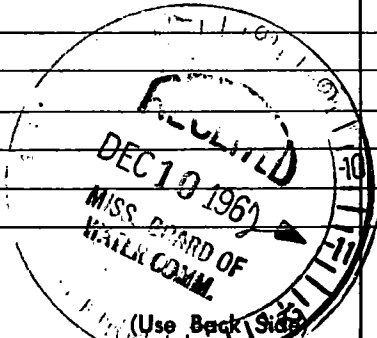

Well No.

000000