

HAR.  
F 33

WATER WELL DRILLERS LOG

**CODED**

Date: 12-10-62, 1962, Driller: Sutton Well Works County Harrison  
(Name)

(1) Owner of Land: Jack Blackwell  
(Name)  
Rt. 2 Hufbert, Miss.  
(Address)

(2) Location: SE 1/4, NE 1/4, Sec. 22 T. 65 R. 12, W  
8 miles W, of Lynum  
(distance) (direction) (Nearest Town)

(3) Topography: hilly  
(Hilly) (Flat) (Level)

(4) Purpose of Well: Domestic  
(Domestic Irrigation  
Municipal, Industrial, Other)

Description & Color of Materials  
Sand, Clay, Red Clay, Shell, etc.

Thickness Feet	Depth Feet
<u>18</u>	<u>18</u>
<u>20</u>	<u>38</u>
<u>519</u>	<u>557</u>
<u>33</u>	<u>590</u>

**CODED**

Information upon completion of well:

(1) Diameter 2 inches.

(2) Total Depth 590 feet.


(3) Water Level 83 feet below top of ground.

(4) Cased to all, Size 2"

(5) Screen: Size 2", Length 10'

(6) Were any formations sealed against pollution?  
yes,  no.

If YES depth of formation \_\_\_\_\_  
Why \_\_\_\_\_  
Drillers Remarks: \_\_\_\_\_

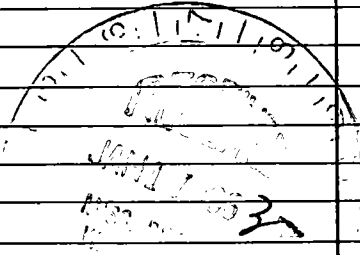

(Use Back Side)

Well No.

