

HAR.

F 35

11-8-63

WATER WELL DRILLERS LOG

CODED

Date: 11-8, 1963, Driller: Sutter Well Works County Harrison

(Name)

(1) Owner of Land: H. M. Daniels (Name)

Long Beach, Miss. (Address)

(2) Location: SW 1/4, SE 1/4, Sec. 35 T65R12W

10 miles N of Cuevas (distance) (direction) (Nearest Town)

(3) Topography: hilly (Hilly) (Flat) (Level)

(4) Purpose of Well: domestic (Domestic Irrigation Municipal, Industrial, Other)

Description & Color of Materials Sand, Clay, Red Clay, Shell, etc.

Thickness Feet

Depth Feet

Hard clay

20

20

clay

105

125

sand

34

159

clay

176

335

sand

14

349

CODED

Information upon completion of well:

(1) Diameter 2 inches.

(2) Total Depth 349 feet.

(3) Water Level 35 feet below top of ground.

(4) Cased to 666, Size 2"

(5) Screen: Size 2", Length 10'


(6) Were any formations sealed against pollution?

yes, no.

If YES depth of formation

Why

Drillers Remarks:

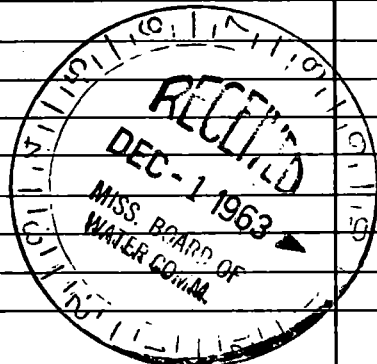

(Use Back Side)

Well No.

0000

[Faint, illegible text, possibly bleed-through from the reverse side of the page. The text is mostly illegible due to low contrast and blurring.]