

F 36

CODED

WATER WELL DRILLERS LOG

11-17-63

Date: Nov 17, 1963, Driller: J. Reed County Harrison

(Name)

(1) Owner of Land: M. M. Sadler
(Name)
Rt 2 Support
(Address)

(2) Location: NE 1/4, NW 1/4, Sec. 7 T6 R12
1 miles East of Lizena
(distance) (direction) (Nearest Town)

(3) Topography: Hilly Flat Level

(4) Purpose of Well: Home
(Domestic Irrigation Municipal, Industrial, Other)

Description & Color of Materials Sand, Clay, Red Clay, Shell, etc.	Thick- ness Feet	Depth Feet
<u>White sand & mud</u>	<u>25</u>	<u>25</u>
<u>Hard Blue mud</u>	<u>65</u>	<u>90</u>
<u>White sand + Red</u>	<u>50</u>	<u>140</u>
<u>Hard Blue mud</u>	<u>163</u>	<u>303</u>
<u>water strata</u>	<u>50</u>	<u>353</u>

CODED

Information upon completion of well:

(1) Diameter 2" 1 1/4" inches.

(2) Total Depth 353 feet.

(3) Water Level 51 feet below top of ground.

(4) Cased to _____, Size _____


(5) Screen: Size 1/4, Length 15 ft

(6) Were any formations sealed against pollution?
 _____ yes, _____ no.

If YES depth of formation _____

Why _____

Drillers Remarks: _____

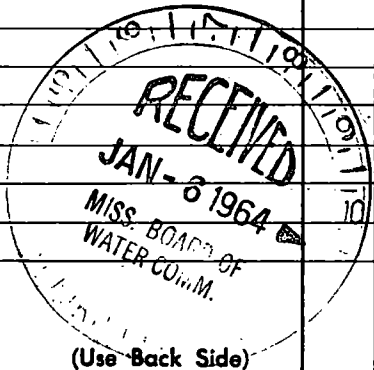

Well No.

