

HAR.

MISSISSIPPI BOARD OF WATER COMMISSIONERS

F38

4-26-64

WATER WELL DRILLERS LOG

**CODED**

Date: Apr 26, 1964, Driller: J. Beal

County: Harrison

(Name)

(1) Owner of Land: E C Labree  
(Name)  
RT 1 Bx 126-A Dawson Min  
(Address)

(2) Location: SE 1/4, DE 1/4, Sec. 4 T6R12  
1/2 miles East, of Lizora  
(distance) (direction) (Nearest Town)

(3) Topography:  (Hilly)  (Flat)  (Level)

(4) Purpose of Well: Home  
(Domestic Irrigation, Municipal, Industrial, Other)

Description & Color of Materials Sand, Clay, Red Clay, Shell, etc.	Thick- ness Feet	Depth Feet
<u>Red Mud + sand</u>	<u>120</u>	<u>120</u>
<u>Blue mud</u>	<u>20</u>	<u>140</u>
<u>Fine sand</u>	<u>7</u>	<u>147</u>
<u>Hard Blue mud</u>	<u>34</u>	<u>181</u>
<u>Fine sand</u>	<u>8</u>	<u>189</u>
<u>Hard Blue mud</u>	<u>336</u>	<u>525</u>
<u>Stratified with sand</u>	<u>10</u>	<u>535</u>

Information upon completion of well:

(1) Diameter 2 inches.

(2) Total Depth 535 feet.

(3) Water Level 33 feet below top of ground.

(4) Cased to \_\_\_\_\_, Size \_\_\_\_\_

(5) Screen: Size \_\_\_\_\_, Length \_\_\_\_\_

(6) Were any formations sealed against pollution?  
Back filled with sand


\_\_\_\_\_ yes, \_\_\_\_\_ no.

If YES depth of formation \_\_\_\_\_

Why \_\_\_\_\_

Drillers Remarks: \_\_\_\_\_

**CODED**

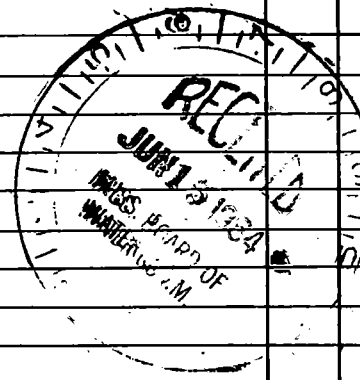

(Use Back Side)

Well No.

0000

