

HAR.  
F40

MISSISSIPPI BOARD OF WATER COMMISSIONERS

7-2-65

WATER WELL DRILLERS LOG

**CODED**

Date: 7-2, 1965, Driller: Sutter Well Works County Harrison

(Name)

(1) Owner of Land: Boy Scouts America  
(Name)

Expt. Troop # 202  
(Address)

(2) Location: NE 1/4, NE 1/4, Sec. 11 T6S R12, W

4 miles W of Syman  
(distance) (direction) (Nearest Town)

(3) Topography: hilly  
(Hilly) (Flat) (Level)

(4) Purpose of Well: Scout Camp  
(Domestic Irrigation  
Municipal, Industrial, Other)

Description & Color of Materials  
Sand, Clay, Red Clay, Shell, etc.

Thick-  
ness  
Feet

Depth  
Feet

Clay

15

15

Black Muck

45

60

Clay

194

254

sand

10

264

**CODED**

Information upon completion of well:

(1) Diameter 3 inches.

(2) Total Depth 264 feet.

(3) Water Level 9 feet below top of ground.

(4) Cased to all, Size 2"

(5) Screen: Size 2", Length 5'


(6) Were any formations sealed against pollution?

no yes,  no.

If YES depth of formation \_\_\_\_\_

Why \_\_\_\_\_

Drillers Remarks: \_\_\_\_\_

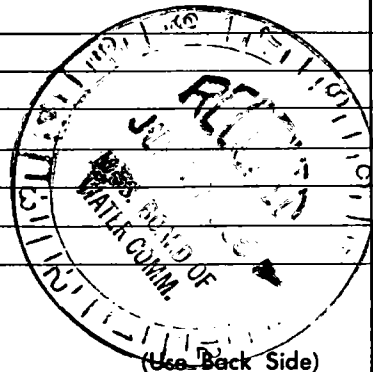

Well No.

