

MISSISSIPPI
BOARD OF WATER COMMISSIONERS
416 North State Street
Jackson, Mississippi 39201

CODED

WATER WELL DRILLERS LOG

Harrison
F47
3-67

3- date well completed 1967 SUTTER Well Works firm name Harrison county well located

LANDOWNER: JACK MORAN

Rt. 3 Box 564

GULFPORT, Miss.
(mailing address)

WELL LOCATION:

sec. 15 T. 6 N. R. 12 E. S. 5 W. W of Syman
(distance) (direction) (nearest town)

WELL PURPOSE: Home
(home, irrigation, municipal, industrial)

WELL COMPLETION DATA:

- (1) diameter (inches) 2 x 2 1/2
- (2) total depth (feet) 262
- (3) static water level (feet) 77 below above top of ground.
- (4) casing GALV. (material), 252 (depth),
2" (size) If telescope see back.
- (5) screen 10' (length), 242' (depth to top)
2" (size), STAINLESS STEEL (material)
- (6) pump 1 1/2 (HP), 15 (yield gpm)
ELEC. (type power)

(7) electric log No. (yes or no)

(organization running log)


(8) how well bottom plugged BP VALVE

description of formations encountered

from to

Clay	0	18
red sand	18	70
Clay	70	143
sand	143	165
Clay	165	230
sand	230	262

CODED

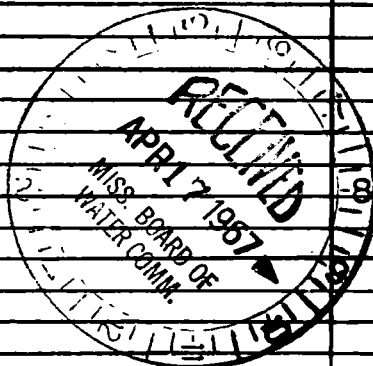

DRILLERS REMARKS:

If well telescopes please sketch and show depths.

GROUND LEVEL

147' of 2 1/2"

105' of
2" pipe

2 x 10' strainer



	X		

SECTION 15

Please indicate well location X.

ADDITIONAL INFORMATION

If more than one screen, show locations of each on sketch.