

Harrison  
748  
9-67

MISSISSIPPI  
 BOARD OF WATER COMMISSIONERS  
 416 North State Street  
 Jackson, Mississippi 39201

**CODED**

WATER WELL DRILLERS LOG

9-8 1967 HATTIESBURG BUTANE HARRISON  
 date well completed firm name county well located

LANDOWNER: Howell J. Cuevas

Route 1 Box 126-C

Sauvier, Miss.  
 (mailing address)

WELL LOCATION:

sec. 4 T. 6 S. R. 12 W.  
4 miles west of LYMAN  
 (distance) (direction) (nearest town)

WELL PURPOSE: HOME  
 (home, irrigation, municipal, industrial)

WELL COMPLETION DATA:


- (1) diameter (inches) 2"
- (2) total depth (feet) 344'
- (3) static water level (feet) 40 below top of ground.
- (4) casing Galv. pipe, 334'  
 (material) (depth)  
2" If telescope see back.  
 (size)
- (5) screen 10', 334'  
 (length) (depth to top)  
2", BRONZE  
 (size) (material)
- (6) pump 1 400  
 (HP) (yield gpm)  
electric  
 (type power)
- (7) electric log NO  
 (yes or no)  
NO  
 (organization running log)
- (8) how well bottom plugged BACK WASH VALVE

description of formations encountered

from to

<u>yellow clay</u>	<u>0</u>	<u>15</u>
<u>white sand</u>	<u>16</u>	<u>23</u>
<u>pink clay</u>	<u>24</u>	<u>37</u>
<u>white clay</u>	<u>38</u>	<u>76</u>
<u>white sand</u>	<u>77</u>	<u>81</u>
<u>white clay</u>	<u>82</u>	<u>105</u>
<u>blue clay</u>	<u>106</u>	<u>330</u>
<u>blue sand</u>	<u>331</u>	<u>338</u>
<u>blue clay</u>	<u>339</u>	<u>344</u>

**CODED**

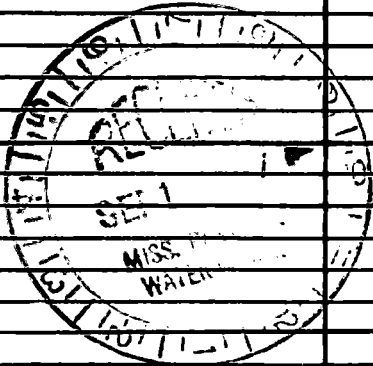

DRILLERS REMARKS:

If well telescopes please sketch and show depths.

GROUND LEVEL

		X 4	

SECTION 4

Please indicate well location X.

ADDITIONAL INFORMATION

Go west from Logans on  
Faylanville Hwy. Turn  
North at old Gatha Ladner  
Store, turn East 1/2 mile  
from Highway - New house.

If more than one screen,  
show locations of each on sketch.