

Harrison
7 49
9-67

MISSISSIPPI
 BOARD OF WATER COMMISSIONERS
 416 North State Street
 Jackson, Mississippi 39201

CODED

WATER WELL DRILLERS LOG

Sept. 17 1967 M & B Drilling Co. Harrison
 date well completed firm name county well located

LANDOWNER: Paul McGill
Highway 53 - Outport, Miss.
 (mailing address)

description of formations encountered	from	to
<u>Red & Yellow Clay</u>	<u>0</u>	<u>22</u>
<u>Red Sand & Clay</u>	<u>22</u>	<u>40</u>
<u>Pink Clay</u>	<u>40</u>	<u>45</u>
<u>White Clay</u>	<u>45</u>	<u>70</u>
<u>Yellow Clay</u>	<u>70</u>	<u>75</u>
<u>Blue Clay</u>	<u>75</u>	<u>120</u>
<u>Blue & White Clay</u>	<u>120</u>	<u>150</u>
<u>Soft Sandy Clay</u>	<u>150</u>	<u>165</u>
<u>Brown Sand</u>	<u>165</u>	<u>202</u>
<u>Pink & White Clay</u>	<u>202</u>	<u>220</u>
<u>Sand</u>	<u>220</u>	<u>225</u>
<u>Clay</u>	<u>225</u>	<u>232</u>
<u>Sand</u>	<u>232</u>	<u>238</u>
<u>Blue Clay</u>	<u>238</u>	<u>365</u>
<u>Coarse Coarse Sand</u>	<u>365</u>	<u>402</u>
<u>Blue Clay</u>	<u>402</u>	<u>-</u>

WELL LOCATION:
 sec. 27 T. 6 N. R. 12 W.
 S. W.
2 miles W of Hydon
 (distance) (direction) (nearest town)


WELL PURPOSE: Farm & Home
 (home, irrigation, municipal, industrial)

WELL COMPLETION DATA:

- (1) diameter (inches) 4 1/2
- (2) total depth (feet) 405
- (3) static water level (feet) 80 below top of ground.
- (4) casing PVC 3 1/2 (material) (depth)
4 1/2 (size) if telescope see back.
- (5) screen 10 (length) 390 (depth to top)
2 1/2" (size) PVC Sand Bar (material)
- (6) pump 1 (HP) 20 (yield gpm)
220V 1/4 HP (type power) Submersible
- (7) electric log No (yes or no)
No (organization running log)
- (8) how well bottom plugged PVC Cap

CODED

Old Well 608 FT
Old Well Before this 202 FT

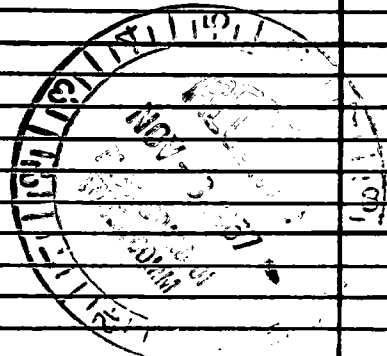

DRILLERS REMARKS:

If well telescopes please sketch and show depths.

GROUND LEVEL

Horizontal Line


160 FT

160 FT
4" PVC

4" PVC
Bushing

2" PVC

390
Sand Pac
400 Screen
5 FT Tail Pipe

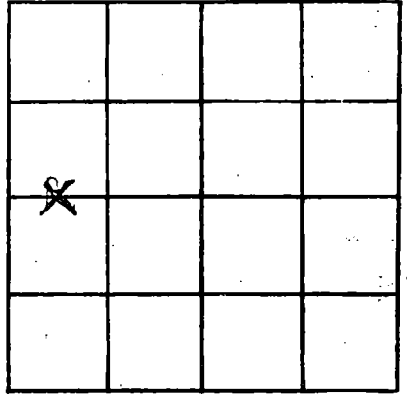

SECTION 24

Please indicate well location X.

ADDITIONAL INFORMATION

Series of horizontal lines for additional information.

If more than one screen, show locations of each on sketch.