

1 1/2 miles from ...

Harrison
~~Jackson~~
 CODED
 F 53 50
 2-68

MISSISSIPPI
 BOARD OF WATER COMMISSIONER
 416 North State Street
 Jackson, Mississippi 39201

CODED

WATER WELL DRILLERS LOG

HARRISON
~~JACKSON~~
 county well located

2-28 1968 date well completed
 Switzer Well Co. firm name

LANDOWNER: James Hooper
 Route 3 Box 500
 Biloxi, Miss
 (mailing address)

WELL LOCATION:
 sec. 22 T. 6 N. R. 12 W.
 S W
 5 miles W of LYMAN
 (distance) (direction) (nearest town)

WELL PURPOSE: Home
 (home, irrigation, municipal, industrial)

WELL COMPLETION DATA:

(1) diameter (inches) 2

(2) total depth (feet) 837

(3) static water level (feet) 17'6" above
 top of ground.

(4) casing gal. steel 827'
 (material) (depth)
 2" if telescope see back.
 (size)

(5) screen 10' 827'
 (length) (depth to top)
 8 ga. ss on pipe
 (size) (material)


(6) pump 1/2 8.5
 (HP) (yield gpm)
 electric
 (type power)

(7) electric log No
 (yes or no)

(organization running log)

description of formations encountered	from	to
clay	0	10
sand	10	22
mixed	22	83
clay	83	166
mixed	166	187
clay	187	197
fine sand	197	207
sand	207	212
fine clay	212	228
fine sand	228	270
hard	270	275
clay	275	291
mixed	291	333
clay	333	351
mixed	351	391
sand	391	399
fine clay	399	391
clay	391	412
mixed	412	433
clay	433	484
sand	484	494
mixed	494	557
fine sand	557	596
mixed	596	657
sand	657	667
fine clay	667	673
sand	673	678
mixed	678	699
fine sand	699	740
fine sand	740	762
good sand	762	839

CODED

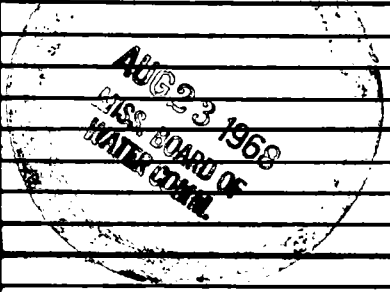


(8) how well bottom plugged Back
 pressure valve

DRILLERS REMARKS:

If well telescopes please sketch and show depths.

GROUND LEVEL

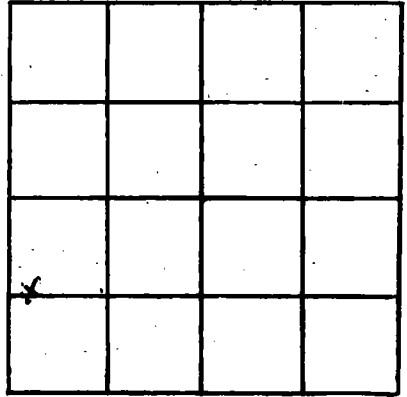

SECTION 22

Please indicate well location X.

ADDITIONAL INFORMATION

If more than one screen, show locations of each on sketch.