

HARRISON
F 51
2-68

MISSISSIPPI
BOARD OF WATER COMMISSIONERS
416 North State Street
Jackson, Mississippi 39201

CODED

WATER WELL DRILLERS LOG

2-14 1968 Butter Well Works Harrison
date well completed firm name county well located

LANDOWNER: Geo. Lett

Rt. 2 Box 116

Greensboro Miss.
(mailing address)

WELL LOCATION:

sec. 24 T. 6 N. R. 12 E.
S. W.
2 miles W of Dynman
(distance) (direction) (nearest town)

WELL PURPOSE: home
(home, irrigation, municipal, industrial)

WELL COMPLETION DATA:


- (1) diameter (inches) 2
- (2) total depth (feet) 241
- (3) static water level (feet) 70 below top of ground.
- (4) casing galv., 231'
(material) (depth)
2" if telescope see back.
(size)
- (5) screen 10', 231'
(length) (depth to top)
2", stainless steel
(size) (material)
- (6) pump 1 (HP) (yield gpm)
elec.
(type power)
- (7) electric log no (yes or no)
(organization running log)
- (8) how well bottom plugged BPU valve

description of formations encountered

from to

<u>sand</u>	<u>0</u>	<u>41</u>
<u>clay</u>	<u>41</u>	<u>162</u>
<u>sand</u>	<u>162</u>	<u>187</u>
<u>clay</u>	<u>187</u>	<u>205</u>
<u>sand</u>	<u>205</u>	<u>241</u>

CODED

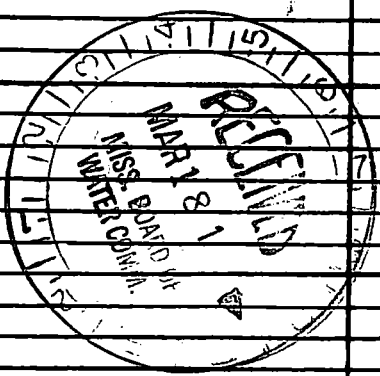

DRILLERS REMARKS:

