

Harrison  
 754  
 7-24-68 CODED

MISSISSIPPI  
 BOARD OF WATER COMMISSIONERS  
 416 North State Street  
 Jackson, Mississippi 39201

**CODED**

WATER WELL DRILLERS LOG

7-24 1968 date well completed  
 Dutton Well Works firm name  
 Harrison county well located

LANDOWNER: Curvis Cuevas  
Rt 2 Box 112  
Gulfport, Miss.  
 (mailing address)

description of formations encountered	from	to
Clay	0	20
sand	20	67
Clay	67	347
sand	347	367


WELL LOCATION:  
 sec. 14 T. 6 N. R. 12 E.  
 S. W.  
4 miles W of Lyman  
 (distance) (direction) (nearest town)

WELL PURPOSE: home  
 (home, irrigation, municipal, industrial)

WELL COMPLETION DATA:

- (1) diameter (inches) 2
- (2) total depth (feet) 367
- (3) static water level (feet) 100 above top of ground.
- (4) casing Galv, 357'  
 (material) (depth)  
2"  
 (size) if telescope see back.
- (5) screen 10', 357'  
 (length) (depth to top)  
2", stainless steel  
 (size) (material)
- (6) pump unknown  
 (HP) (yield gpm)  
 (type power)
- (7) electric log no  
 (yes or no)  
 (organization running log)
- (8) how well bottom plugged BP Value

**CODED**

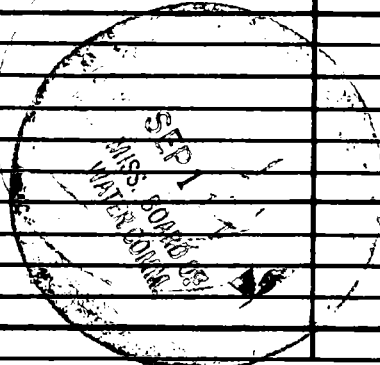

DRILLERS REMARKS:

If well telescopes please sketch and show depths.

GROUND LEVEL

X			

SECTION 14

Please indicate well location X.

**ADDITIONAL INFORMATION**

Handwritten notes and lines in the additional information section, including the number "1175" repeated several times and other illegible scribbles.

If more than one screen, show locations of each on sketch.