

Harrison
 F55
 5-68

MISSISSIPPI
 BOARD OF WATER COMMISSIONERS
 416 North State Street
 Jackson, Mississippi 39201

CODED

WATER WELL DRILLERS LOG

May 1968 Coastal Drilling Harris
 date well completed firm name county well located

LANDOWNER:
 Thos N. Roberts Jr.
 4704 Kurbell Ave. Mt. Zion
 (mailing address)

description of formations encountered	from	to
white sand	1	33
Cherty sand	33	65
iron gravel	65	90
spiral clay	90	225
Blue clay	225	304
very fine sand	304	326
fine sand	326	348
Coarse sand	348	358

WELL LOCATION:
 sec 36 T. 6 N. R. 12 E
 13 SW 1/4
 1/2 miles SW of Lyman
 (distance) (direction) (nearest town)

WELL PURPOSE: Flam
 (home, irrigation, municipal, industrial)

WELL COMPLETION DATA:

- (1) diameter (inches) 2"
- (2) total depth (feet) 358
- (3) static water level (feet) below top of ground
- (4) casing 2" galv 358
 (material) (depth)
 (size) if telescope see back.
- (5) screen 10' 55
 (length) (depth to top)
2" SS
 (size) (material)
- (6) pump 1 13 1/2
 (HP) (yield gpm)
Elc
 (type power)
- (7) electric log yes or no
 (organization running log)
- (8) how well bottom plugged very good

CODED


DEC 18 1968

MISC. ED. OF
 WATER COM.

DRILLERS REMARKS:

If well telescopes please sketch and show depths.

GROUND LEVEL

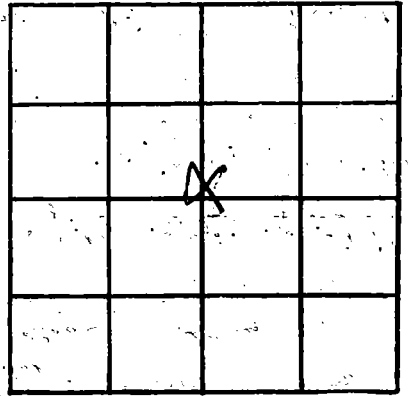

SECTION _____

Please indicate well location X.

ADDITIONAL INFORMATION

If more than one screen, show locations of each on sketch.