

HARRISON
 F 56
 3-6-69

MISSISSIPPI
 BOARD OF WATER COMMISSIONERS
 416 North State Street
 Jackson, Mississippi 39201

CODER

WATER WELL DRILLERS LOG

3/6/69 19 R. J. MOORE HARRISON
 date well completed firm name county well located

LANDOWNER: A. H. JAMES
PT 3 COUNTY FARM RD
GULFPORT, MISS
 (mailing address)
 WELL LOCATION:
 sec 22 T 6 N R 12 E
 (distance) miles 8 west of LYMAN
 (direction) (nearest town)

description of fomations encountered	from	to
Red CLAY	0	18
RUSTY SAND	18	25
White CLAY	25	160
Red SAND	160	190
Blue CLAY	190	260
Blue SAND (FINE)	260	265
Blue CLAY	265	305
Blue SAND (FINE)	305	308
Blue CLAY	308	356
Blue SAND (MED)	356	385
Blue CLAY	385	387

WELL PURPOSE:
 (home, irrigation, municipal, industrial)

- WELL COMPLETION DATA:
- (1) diameter (inches) 2"
 - (2) total depth (feet) 387'
 - (3) static water level (feet) 65' below above top of ground.
 - (4) casing 2 1/2", 367'
 (material) (depth)
 - (size) if telescope see back.
 - (5) screen 10', 367'
 (length) (depth to top)
 - 2", SS
 (size) (material)
 - (6) pump 1, 520
 (HP) (yield gpm)
 - E
 (type power)
 - (7) electric log (yes or no)

CODER


(organization running log)

(8) how well bottom plugged B.W
live

DRILLERS REMARKS:

If well telescopes please sketch and show depths.

GROUND LEVEL

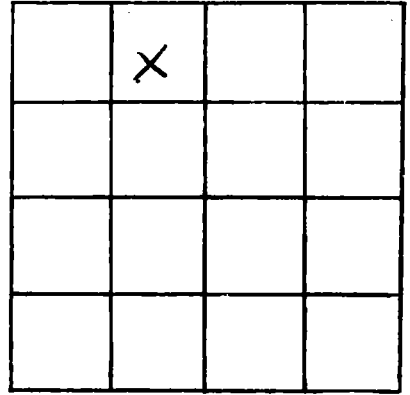

SECTION 22

Please indicate well location X.

ADDITIONAL INFORMATION

Lined area for additional information, consisting of multiple horizontal lines.

If more than one screen, show locations of each on sketch.