

Harrison  
757  
1-7-69

MISSISSIPPI  
BOARD OF WATER COMMISSIONERS  
416 North State Street  
Jackson, Mississippi 39201

CODED

WATER WELL DRILLERS LOG

CODED

1-7 1969 date well completed  
Switzer Hall Co. firm name  
Harrison county well located

LANDOWNER: Bennett Pierce

Route 2, Box 4515

Bulfsport Miss.  
(mailing address)

description of formations encountered	from to	
clay	0	22
mixed	22	65
clay	65	122
sand	122	127
mixed	127	148
fine sand	148	208
fair sand	208	244

WELL LOCATION:

sec 36 T 6 N R 12 E  
S W  
8 miles NW of BULFSPORT  
(distance) (direction) (nearest town)

WELL PURPOSE: Home  
(home, irrigation, municipal, industrial)

Well set 227'

WELL COMPLETION DATA:

- (1) diameter (inches) 2
- (2) total depth (feet) 227
- (3) static water level (feet) 44 below top of ground above
- (4) casing gal steel, 217' (material) (depth)  
2" (size) if telescope see back.
- (5) screen 10' (length), 217' (depth to top)  
8 ga, ss on pipe (size) (material)
- (6) pump 1 (HP) (yield gpm)  
electric (type power)
- (7) electric log No (yes or no)

RECEIVED

(organization running log)

(8) how well bottom plugged back pressure valve


APR 18 1969

DRILLERS REMARKS:

MISS. BD. OF  
WATER COMM.

If well telescopes please sketch and show depths.

GROUND LEVEL

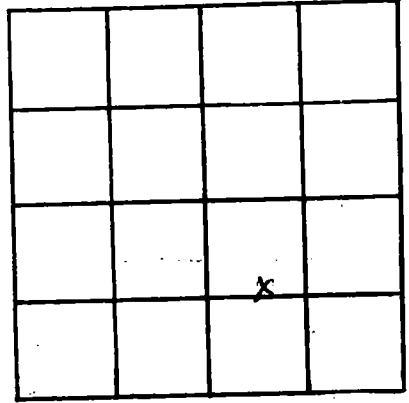

SECTION 36

Please indicate well location X.

ADDITIONAL INFORMATION

If more than one screen, show locations of each on sketch.