

CODED

Harrison
759
5-9-69

MISSISSIPPI
BOARD OF WATER COMMISSIONERS
416 North State Street
Jackson, Mississippi 39201

WATER WELL DRILLERS LOG

May 9 69 date well completed
MOR Drilling Co. firm name
Harrison county well located

LANDOWNER: William Turner
P.O. Crispont, Miss.
(mailing address)

WELL LOCATION:
sec. 15 T. 6 S. R. 12 W.
2 1/2 miles NW Lyman
(distance) (direction) (nearest town)

WELL PURPOSE: Home
(home, irrigation, municipal, industrial)

- WELL COMPLETION DATA:
- (1) diameter (inches) 2
 - (2) total depth (feet) 184
 - (3) static water level (feet) 55 below top of ground
 - (4) casing (material) PVC Total (depth) 2" If telescope see back.
 - (5) screen 9 FT 171 (length) (depth to top) 2" PVC Sand Pac (size) (material)
 - (6) pump 1 (HP) 8 (yield gpm) 110/10 (type power)
 - (7) electric log No (yes or no)

description of formations encountered	from	to
Surface	0	6
Yellow Clay	6	12
Red Clay	12	16
Sand	16	44
White & Purple Clay	44	60
White Clay	60	90
Tan Clay	90	125
White Sand	125	180
Brown Blue Clay	180	184

(organization running log)
(8) how well bottom plugged 2" PVC Cap


DRILLERS REMARKS:

JUN 2 - 1969

MISS. BD. OF
WATER COMM.

If well telescopes please sketch and show depths.

GROUND LEVEL

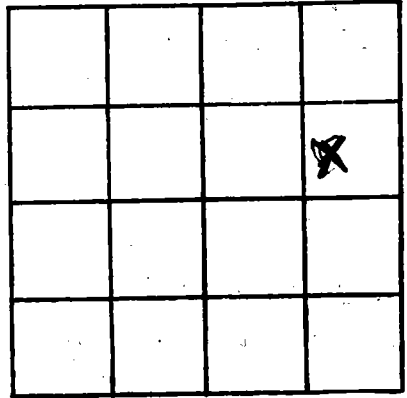

SECTION 15

Please indicate well location X.

ADDITIONAL INFORMATION

If more than one screen, show locations of each on sketch.