

Harrison
761
9-25-69

MISSISSIPPI
BOARD OF WATER COMMISSIONERS
416 North State Street
Jackson, Mississippi 39201

CODE#

WATER WELL DRILLERS LOG

9-25
date well completed

1969 R. J. Moore
firm name

HARRISON
county well located

LANDOWNER: V. E. CARTER
RT 2 Box 440 JOHN CLARK RD
GULFPORT, MISS
(mailing address)

| description of formations encountered | from to | |
|---------------------------------------|---------|-----|
| | | |
| TOP SOIL | 0 | 10 |
| RED SAND | 10 | 16 |
| WHITE & BLUE CLAY | 16 | 100 |
| RED COARSE SAND | 100 | 115 |
| BLUE CLAY | 115 | 122 |
| GRAY SAND | 122 | 210 |

WELL LOCATION:

sec. 26 T 6 N R 12 E
3 miles WEST of NARUT
(distance) (direction) (nearest town)

WELL PURPOSE:
(Home, Irrigation, municipal, industrial)

WELL COMPLETION DATA:

- (1) diameter (inches) 2"
- (2) total depth (feet) 210
- (3) static water level (feet) 42' below top of ground
- (4) casing 942 (material), 198 (depth), 2" (size) if telescope see back.
- (5) screen 2x10 (length), 198 (depth to top), 2" (size), SS (material)
- (6) pump 1 (HP), 660 GPM (yield gpm), Elec (type power)
- (7) electric log (yes or no)
- (organization running log)
- (8) how well bottom plugged Bw


OCT 4 - 1969

MISS. BD. OF
WATER COMMISSIONERS

DRILLERS REMARKS:

If well telescopes please sketch and show depths.

GROUND LEVEL

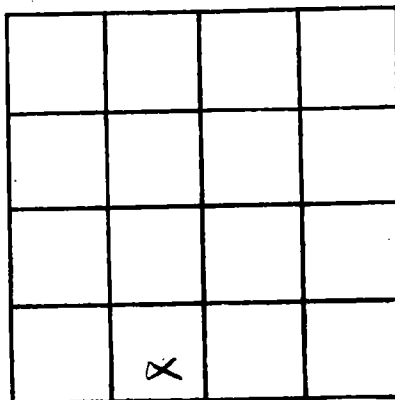

SECTION 26

Please indicate well location X.

ADDITIONAL INFORMATION

If more than one screen, show locations of each on sketch.