

Harrison  
 F62  
 9-27-69

MISSISSIPPI  
 BOARD OF WATER COMMISSIONERS  
 416 North State Street  
 Jackson, Mississippi 39201

CODED

WATER WELL DRILLERS LOG

9-27 1969 R. J. Moore Harrison  
 date well completed firm name county well located


LANDOWNER: <u>Dempsey Coe Vias</u> <u>LIZANA, MISS</u>	description of formations encountered	from	to
(mailing address)	<u>Red white clay</u>	0	20
WELL LOCATION:	<u>White clay &amp; sand</u>	20	40
sec. <u>12</u> T. <u>6</u> N. R. <u>12</u> E. <u>1 1/2</u> miles <u>EAST</u> of <u>LIZANA</u> (distance) (direction) (nearest town)	<u>White sand (chalky)</u>	40	50
WELL PURPOSE: <u>TRAILER</u> (home, irrigation, municipal, industrial)	<u>White clay</u>	50	72
WELL COMPLETION DATA:	<u>White sand fine</u>	72	104
(1) diameter (inches) <u>2"</u>	<u>Blue clay</u>	104	152
(2) total depth (feet) <u>189</u>	<u>Blue sand</u>	152	189
(3) static water level (feet) <u>54'</u> <u>below</u> top of ground.			
(4) casing <u>2 1/2</u> (material), <u>179</u> (depth). <u>2"</u> (size) if telescope see back.			
(5) screen <u>2x10</u> (length), <u>129</u> (depth to top). <u>2"</u> (size), <u>SS</u> (material)			
(6) pump <u>1</u> (HP), <u>620</u> (yield gpm). <u>E</u> (type power)			
(7) electric log <u>—</u> (yes or no) <u>—</u> (organization running log)			
(8) how well bottom plugged <u>BW</u> <u>2 1/2"</u>			
DRILLERS REMARKS:			

OCT 4 - 1969

MISS. BD OF  
 WATER COMM.

If well telescopes please sketch and show depths.

GROUND LEVEL

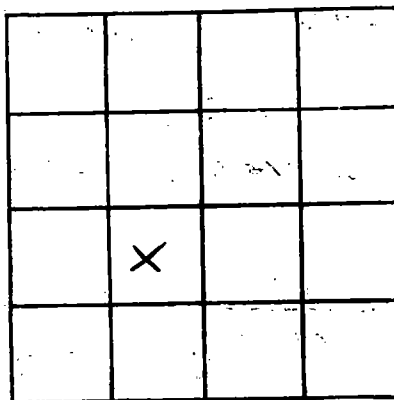

SECTION 17

Please indicate well location X.

ADDITIONAL INFORMATION

If more than one screen, show locations of each on sketch.